PREPARED FOR: JOHN LAW REMAX - GENEVA REALTY 101 BROAD ST, SUITE 102 LAKE GENEVA, WI 53115

JOB #: 07-081


TAX(ID #: JLFE 00022

PLAT OF SURVEY

- OF -

LOT 22 OF LAKE FOREST ESTATES, A SUBDIVISION LOCATED IN THE NORTHWEST, SOUTHWEST, AND SOUTHEAST 1/4'S OF THE SOUTHWEST 1/4 OF SECTION 26, THE SOUTHEAST AND NORTHEAST 1/4'S OF THE SOUTHEAST 1/4 OF SECTION 27, AND THE NORTHEAST 1/4 OF THE NORTHWEST 1/4 OF SECTION 35, ALL IN TOWN 2 NORTH, RANGE 17 EAST, TOWN OF GENEVA, WOLWORTH COUNTY, WISCONSIN.

PATHFINDER SURVEYING INC. W2888 KRUEGER ROAD, UNIT "D" LAKE GENEVA, WI, 53147 262-248-3697

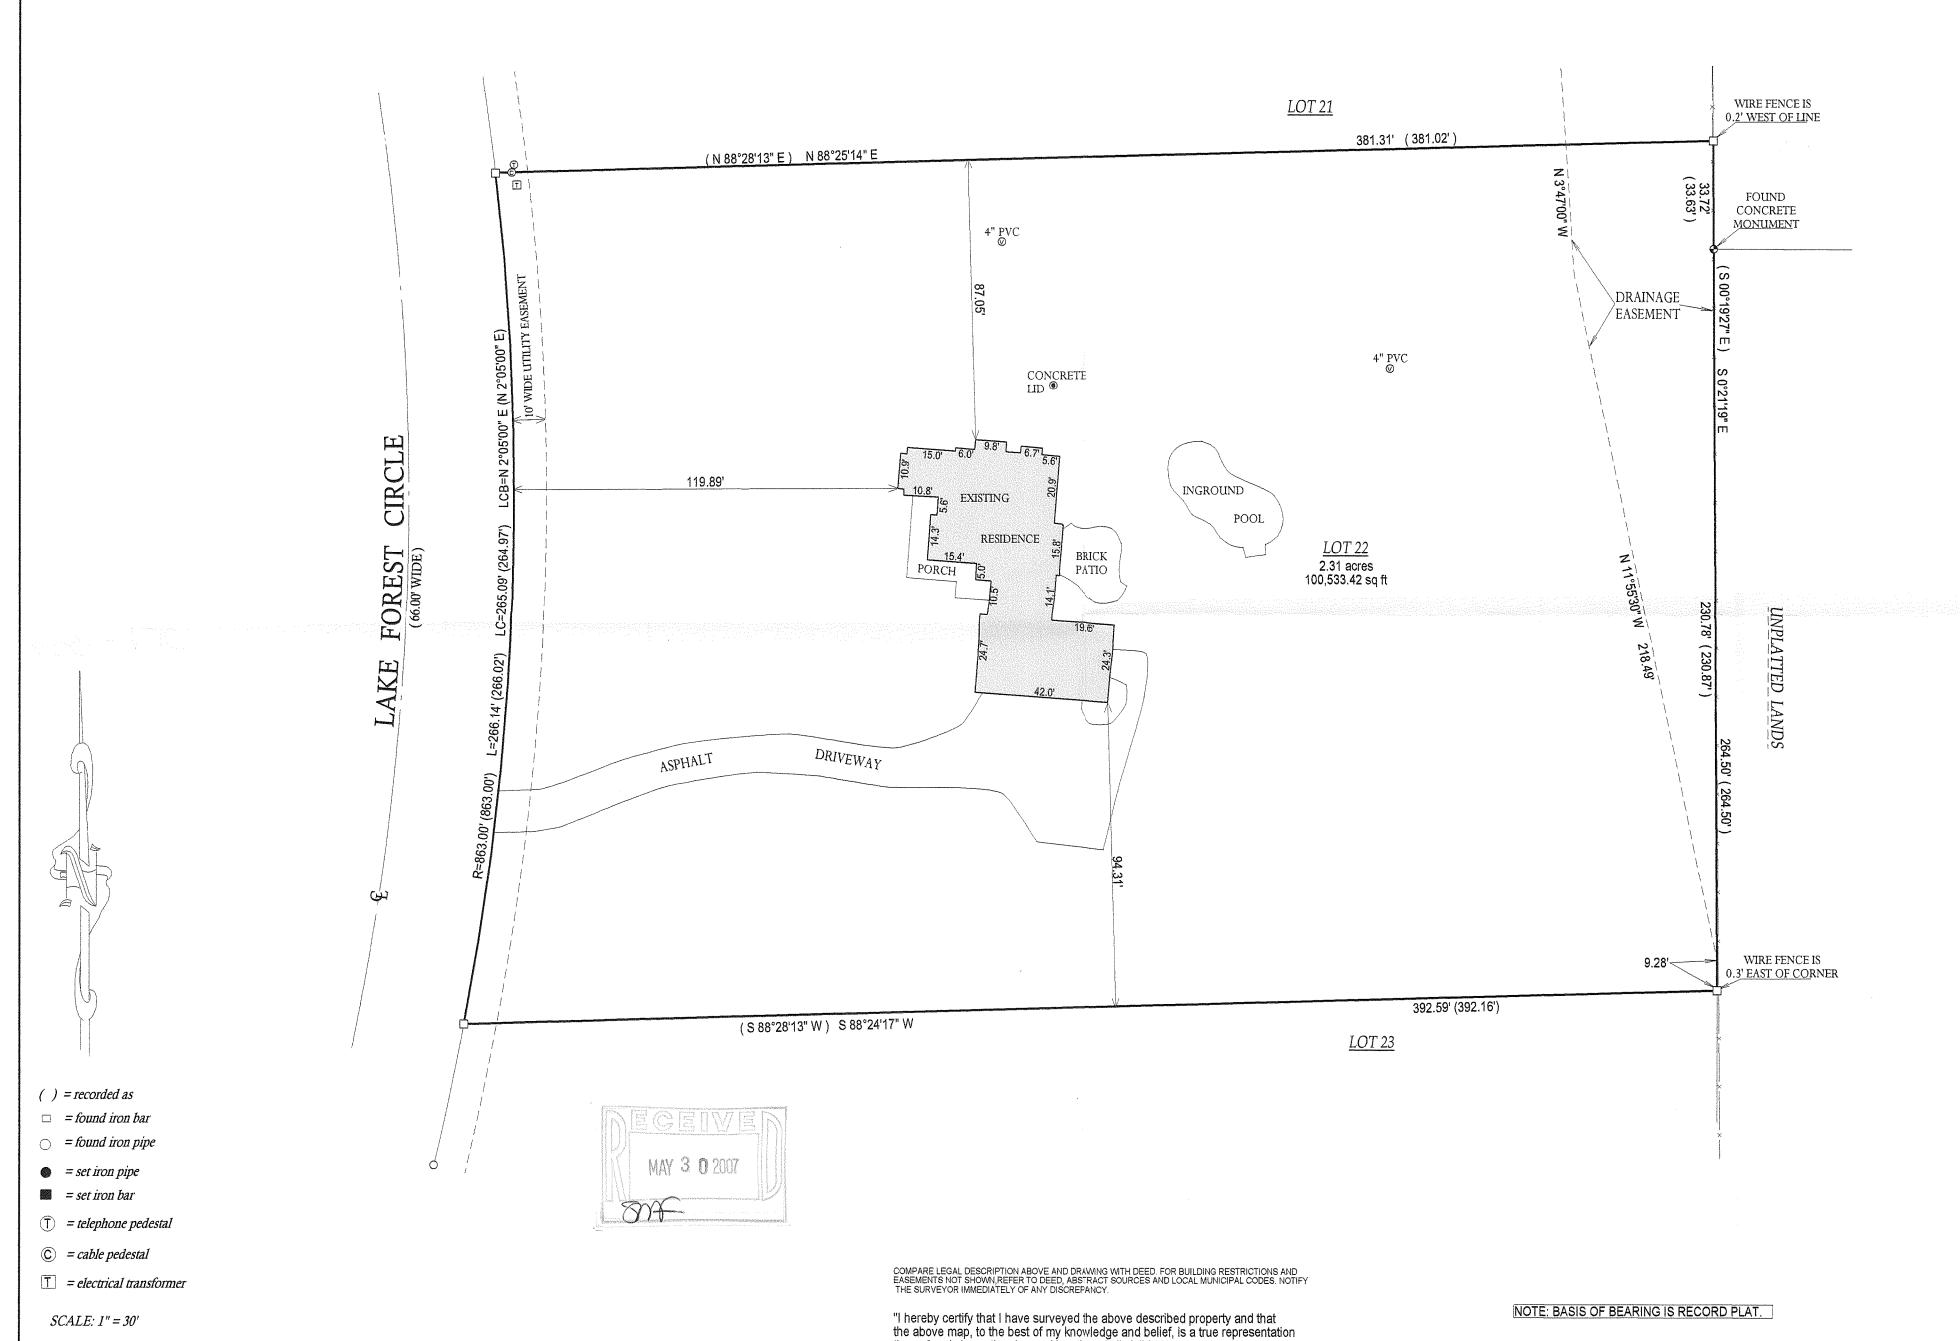

thereof and shows the size and location of all visible structures, apparent easements and encroachmentsif any." This survey is made for the present

title thereto, within one year from the date hereof.

owners of the property, and those who purchase, mortgage, or guarentee the

(original if signed in red)

JOHN P. KROTT

S-2258

WIS.

JOHN KROTT S - 2258

Wisconsin Registered Land Surveyor

DATED THIS 13th DAY OF MARCH, 2007.