ORDERED BY:
ATTORNEY DAVID WILLIAMS
FOR:
JUDY OLSEN
2601 BEVERLY DR.
TUSCON, AZ. 85716

PLAT OF SURVEY


- OF -


PATHFINDER SURVEYING INC. (formerly) J.K. SURVEYING INC. W2888 KRUEGER RD. UNIT D LAKE GENEVA, WI, 53147 262-248-3697

LOTS 4428 THRU 4431 BLOCK 77 OF LAKE COMO BEACH SUBDIVISION; LOCATED IN TOWN 2 NORTH, RANGE 17 EAST, TOWN OF GENEVA, COUNTY OF WALWORTH, STATE OF WISCONSIN.

LAKEVIEW DRIVE

(PLATTED AS LINCOLN DRIVE 50' WIDE)

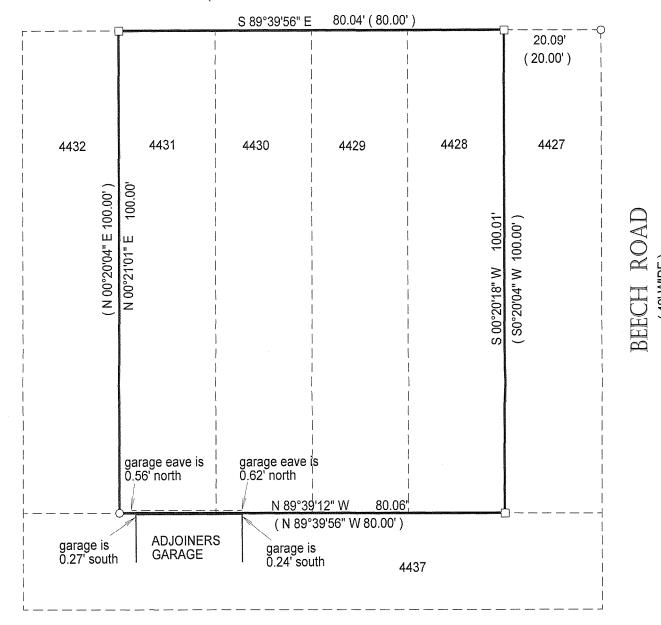

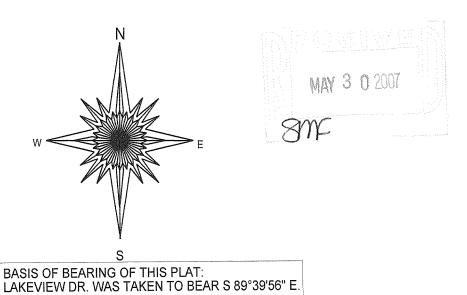

()= recorded as

= found iron bar

= found iron pipe

= set iron pipe

= set iron bar

COMPARE LEGAL DESCRIPTION ABOVE AND DRAWING WITH DEED. FOR BUILDING RESTRICTIONS AND EASEMENTS NOT SHOWN, REFER TO DEED, ABSTRACT SOURCES AND LOCAL MUNICIPAL CODES. NOTIFY THE SURVEYOR IMMEDIATELY OF ANY DISCREPANCY.

SCALE 1" = 20'

JOB # 07-054

TAX ID # JLCB 00870

"I hereby certify that I have surveyed the above described property and that the above map is a true representation of its exterior boundaries and shows the size and location of all visible structures, apparent easements and encroachments if any." This survey is made for the present owners of the property, and those who purchase, mortgage, or guarantee the title thereto, within one year from the date hereof.

DATED THIS 20 TH, DAY OF February 20 07



JEFFREY L KIMPS S - 2436 Wisconsin Registered Land Surveyor (original if signed in red)