

SITE, GRADING, DRAINAGE  
& EROSION CONTROL PLAN

WORK ORDERED BY  
BAYWOOD HEIGHTS LIMITED PARTNERS  
C/O: PAT MOORE  
P.O. BOX 47  
WILLIAMS BAY, WISCONSIN

FARRIS, HANSEN & ASSOCIATES, INC.  
Engineering, Architecture, Surveying  
7 Ridgeway Court P.O. Box 437  
ELKHORN, WISCONSIN 53121  
Office: (262) 723-2098  
Fax: (262) 723-5886


REVISIONS  
ADVANCEMENT  
BS 11-13-06  
ADVANCEMENT  
BS 04-09-07

PROJECT NO.  
3269.11-01  
DATE:  
04-04-01  
SHEET NO.  
1 OF 5

# PLAT OF SURVEY

UNIT 11-01  
GENEVA NATIONAL CONDOMINIUM  
NO. 11

LOCATED IN TOWN 2 NORTH, RANGE 17 EAST  
WALWORTH COUNTY, WISCONSIN

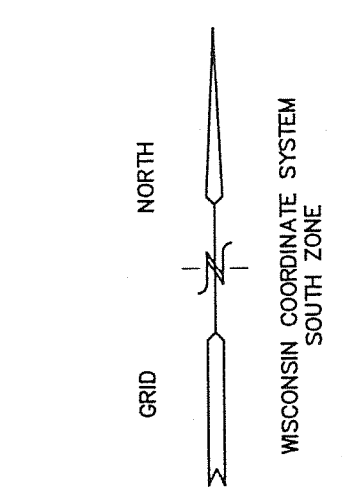


EXISTING RESIDENCE  
TOF = 1052.83'

UNIT 11-02

UNIT 11-01  
22,600 S.F.

GOLF CLUB GROUNDS



- = FOUND IRON REBAR STAKE
- = SET IRON REBAR STAKE
- (xxx) = RECORDED AS
- = HYDRANT
- ⊕ = SANITARY MANHOLE

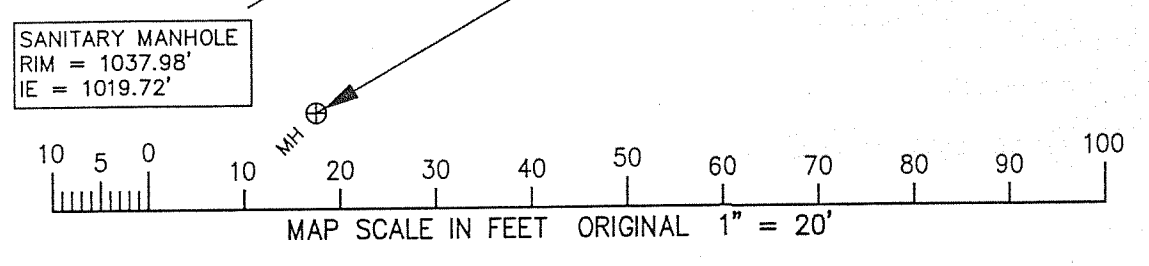

TOP GOV'T  
WITNESS MONUMENT  
EL. = 1041.93'  
PROTECT

SANITARY MANHOLE  
RIM = 1037.93'  
IE = 1024.52'

SANITARY MANHOLE  
RIM = 1038.63'  
IE = 1023.34'

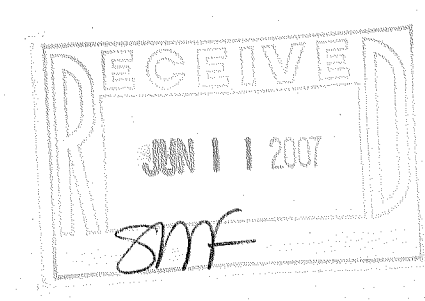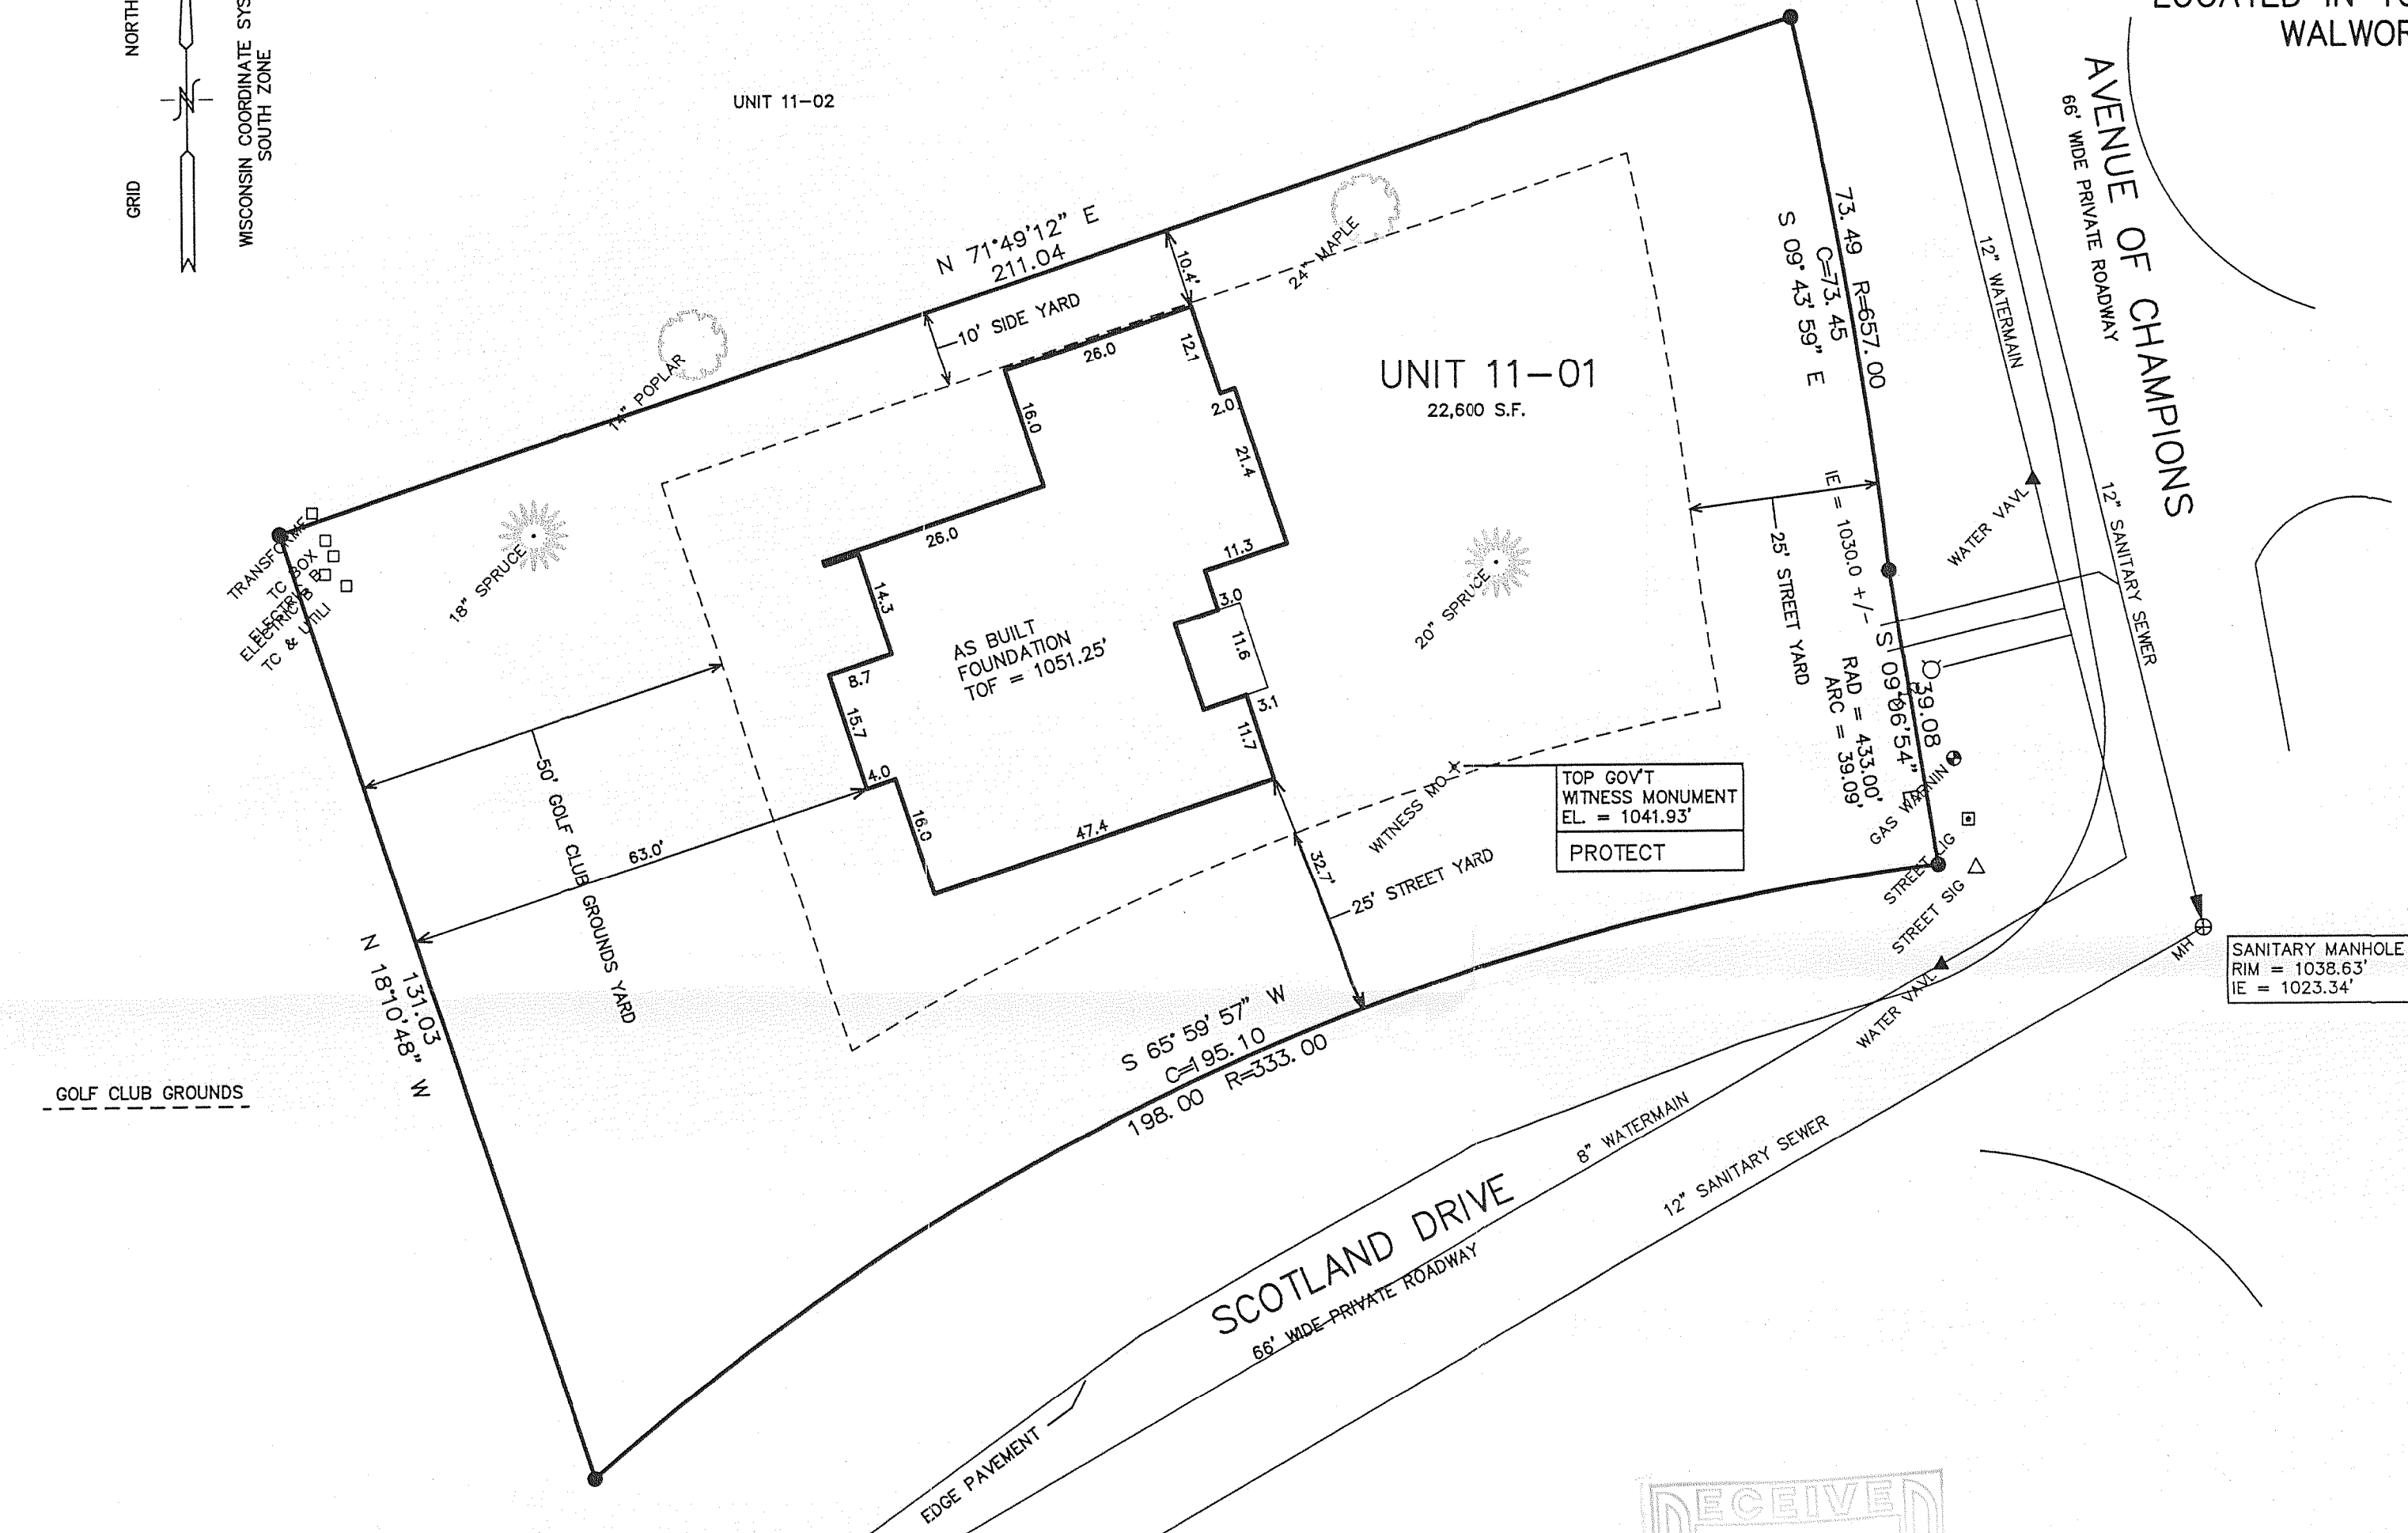

NOTE: COPIES OF THIS MAP TO WHICH THE FOLLOWING CERTIFICATE WILL APPLY SHOW SURVEYOR'S ORIGINAL SEAL AND SIGNATURE IN RED INK. COPIES BY ANY OTHER MEANS MAY HAVE ALTERATIONS WHICH DO NOT REPRESENT THE SURVEYOR'S WORK PRODUCT.

I HEREBY CERTIFY THAT THE ABOVE DESCRIBED PROPERTY HAS BEEN SURVEYED UNDER MY DIRECTION AND THAT THE ABOVE MAP IS A TRUE REPRESENTATION THEREOF AND SHOWS THE SIZE AND LOCATION OF THE PROPERTY AND ITS EXTERIOR BOUNDARIES. THIS SURVEY IS MADE FOR THE USE OF THE PRESENT OWNERS OF THE PROPERTY, AND ALSO THOSE WHO PURCHASE, MORTGAGE, OR GUARANTEE THE TITLE THERETO WITHIN ONE YEAR FROM THE DATE HEREOF.

DATED: MAY 1, 2001  
  
PETER S. GORDON R.L.S. 2101

REVISED 04-25-2007  
TO SHOW SIZE & LOCATION OF  
AS BUILT FOUNDATION

JGN 11-1

217-3402