


# SITE, GRADING, DRAINAGE & EROSION CONTROL PLAN

BATWOOD HEIGHTS LIMITED PARTNERS  
C/O: PAT MOORE  
P.O. BOX 47  
BATWOOD, WV 26039

## MISSIONS

PROJECT NO.	69.15-13
DATE:	-05-01
SHEET NO.	OF 5

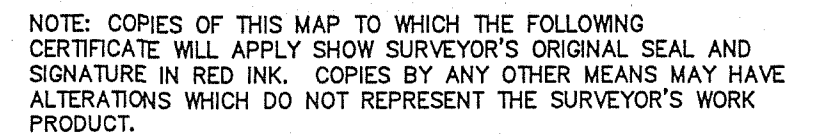

REVISED 04-25-2007  
TO SHOW SIZE & LOCATION OF  
AS BUILT FOUNDATION

PETER S. GORDON R.L.S. 2101

217-3403