



PLAT OF SURVEY

JUN 1 8 2007

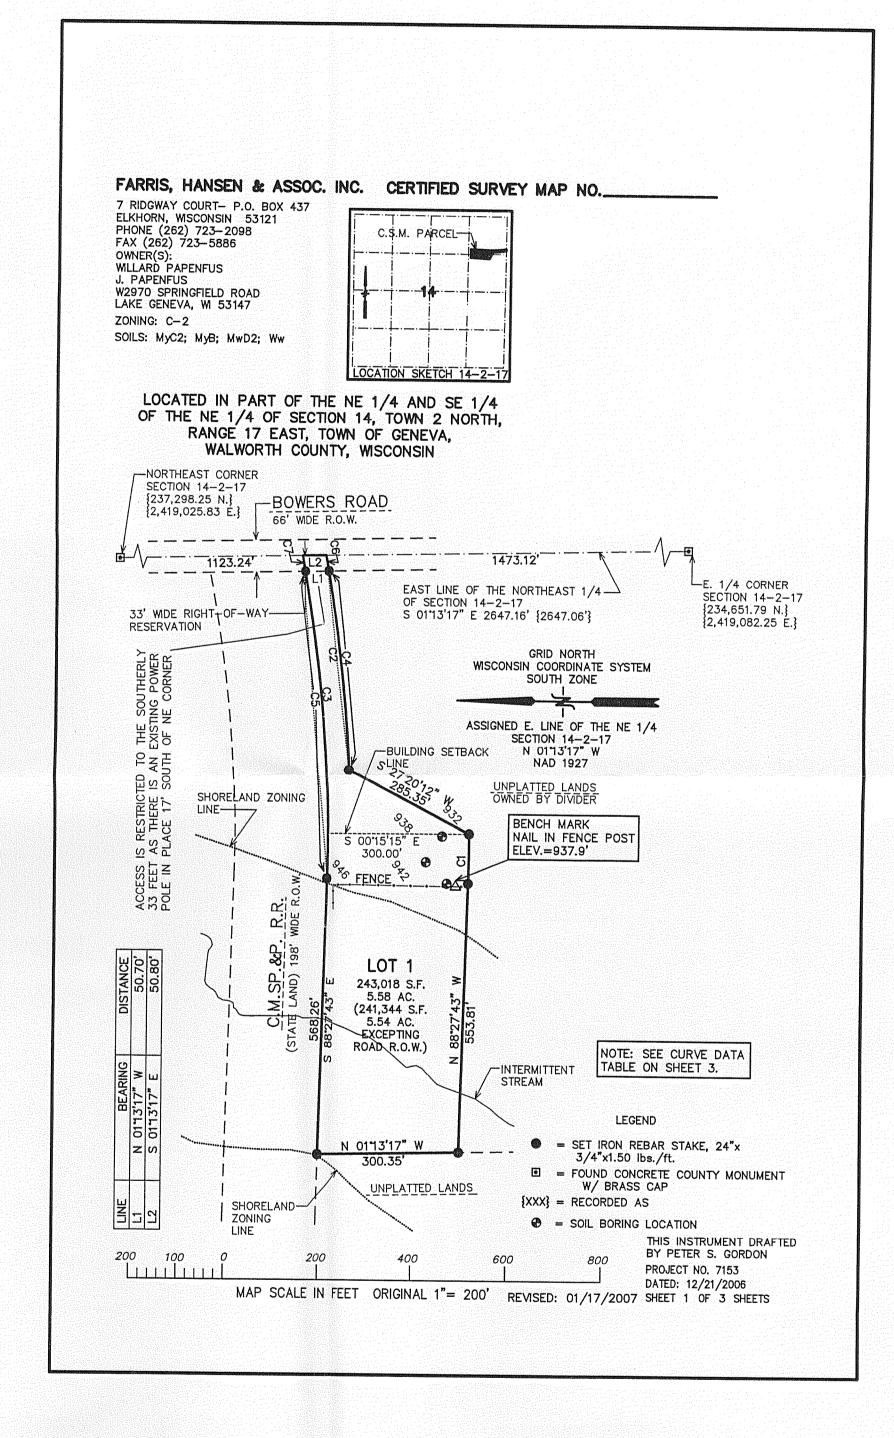

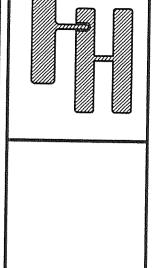

HANSEN & RING - ARCHIT RIDGWAY COURT ELKHORN, WISC

REVISIONS

PROJECT NO. 7153

DATE 02/14/2007 SHEET NO.

1 OF 1

REVISED 05-23-2007 TO SHOW SIZE & LOCATION OF AS BUILT FOUNDATION

NOTE: COPIES OF THIS MAP TO WHICH THE FOLLOWING CERTIFICATE WILL APPLY SHOW THE SURVEYOR'S ORIGINAL SEAL AND SIGNATURE IN RED INK. COPIES BY ANY OTHER MEANS MAY HAVE ALTERATIONS

I HEREBY CERTIFY THAT THE ABOVE DESCRIBED PROPERTY HAS BEEN SURVEYED UNDER MY DIRECTION AND THAT THE ABOVE MAP IS A TRUE REPRESENTATION THEREOF AND SHOWS THE SIZE AND LOCATION OF THE PROPERTY AND ITS EXTERIOR BOUNDARIES. THIS SURVEY IS

MADE FOR THE USE OF THE PRESENT OWNERS OF THE PROPERTY, AND ALSO THOSE WHO PURCHASE, MORTGAGE, OR GUARANTEE THE TITLE

WHICH DO NOT REPRESENT THE SURVEYOR'S WORK PRODUCT.

THERETO WITHIN ONE YEAR FROM THE DATE HEREOF.

DATED: FEBRUARY 14, 2007

PETER S. GORDON R.L.S. 2101

5-2101