


# HAROLD H. KOLB

REGISTERED PROFESSIONAL LAND SURVEYOR  
LAKE GENEVA, WISCONSIN

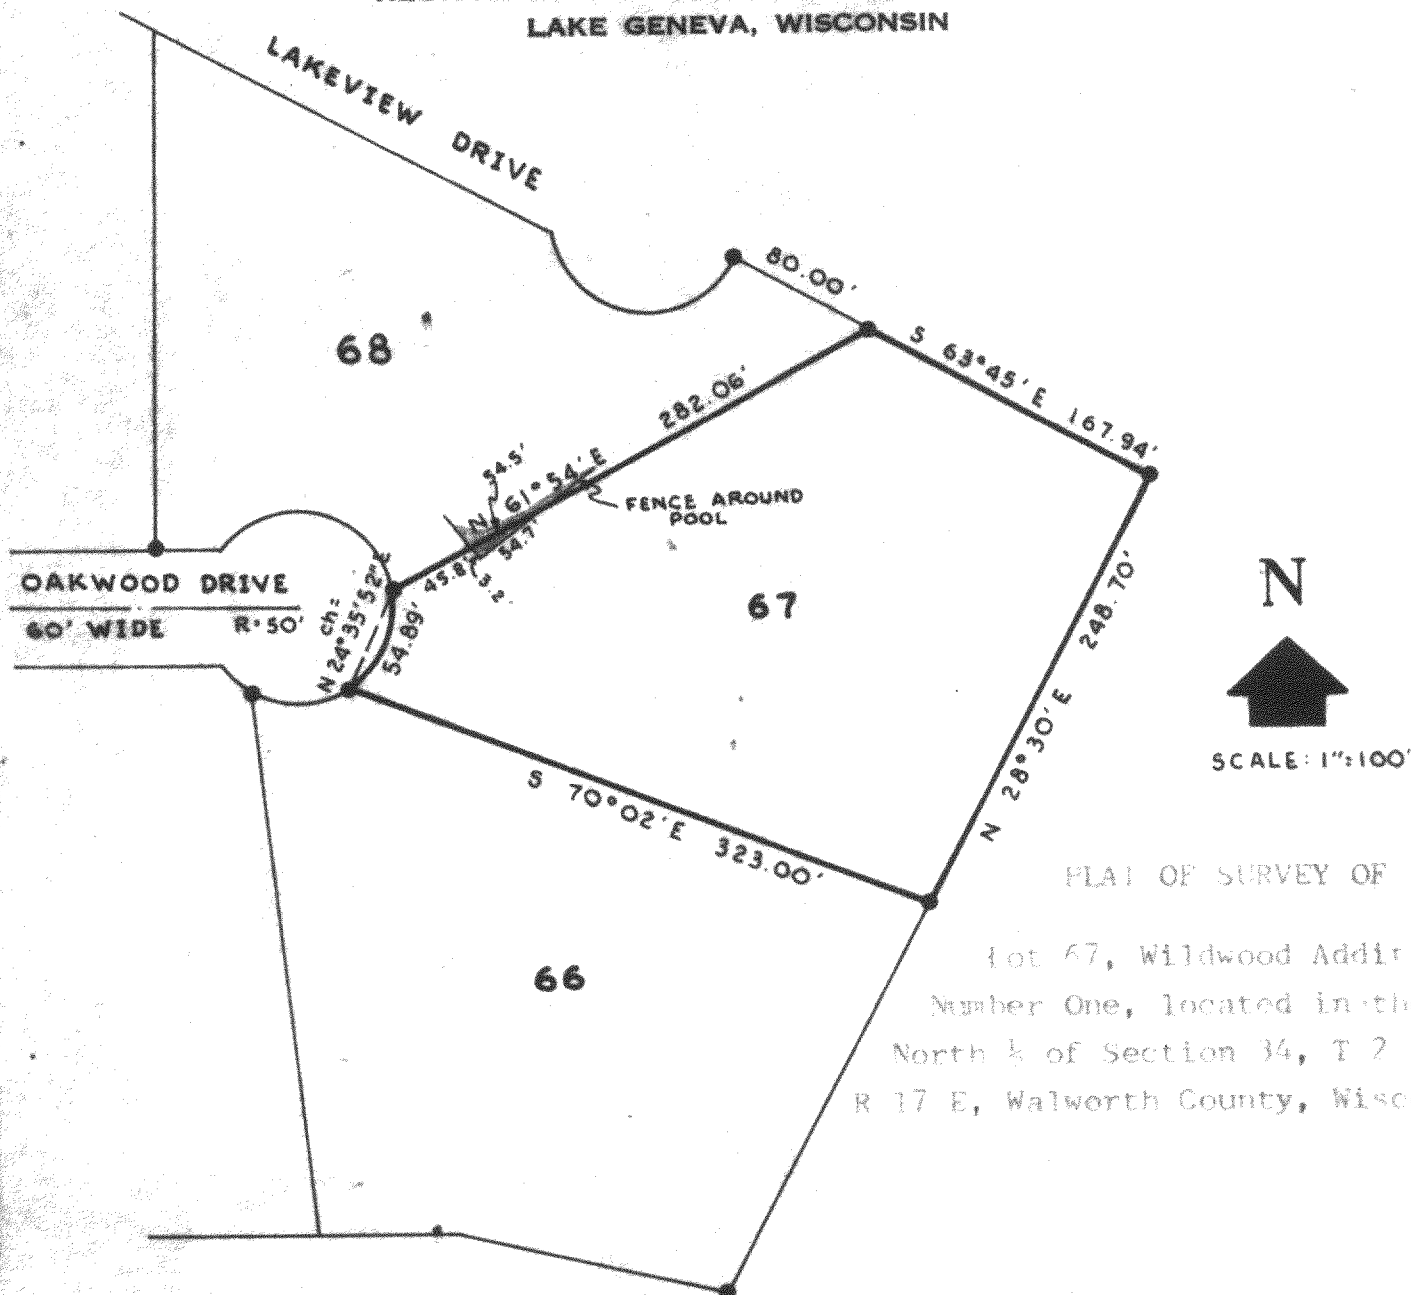


PLAT OF SURVEY OF

Lot 67, Wildwood Addition  
Number One, located in the  
North  $\frac{1}{4}$  of Section 34, T 2 N,  
R 17 E, Walworth County, Wisconsin

## LEGEND

- ◆ - IRON PIPE FOUND
- - IRON PIPE PLACED
- - Iron Rod Found
- x - SPIKE

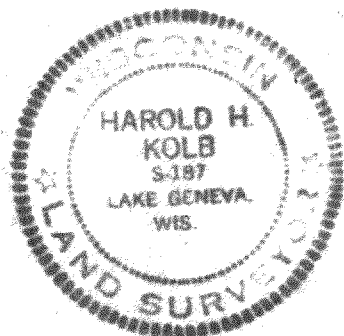

I, HAROLD H. KOLB, DO HEREBY CERTIFY THAT I HAVE  
SURVEYED THE PROPERTY HEREON DESCRIBED ACCORDING  
TO THE OFFICIAL RECORDS, AND THAT THE PLAT HEREON  
IS A CORRECT REPRESENTATION OF THE LOT LINES.

*Harold H. Kolb*

HAROLD H. KOLB  
WISCONSIN REGISTERED LAND SURVEYOR, S-187

DATE March 8, 1973

REVISED: April 2, 1973

217-346