PREPARED FOR CHUCK KAZDA PO. BOX 885 ELKHORN WI. 53121


## PLAT OF SURVEY

-OF-

KROTT SURVEYING INC. N3705 WILLOW BEND LANE LAKE GENEVA WI. 53147

> PHONE # (262)248-3697 FAX # (262)249-0639

LOTS 4415 - 4416 , & 4424 - 4426 BLOCK 76 OF LAKE COMO BEACH SUBDIVISION; LOCATED IN TOWN 2 NORTH, RANGE 17 EAST, WALWORTH COUNTY, WISCONSIN

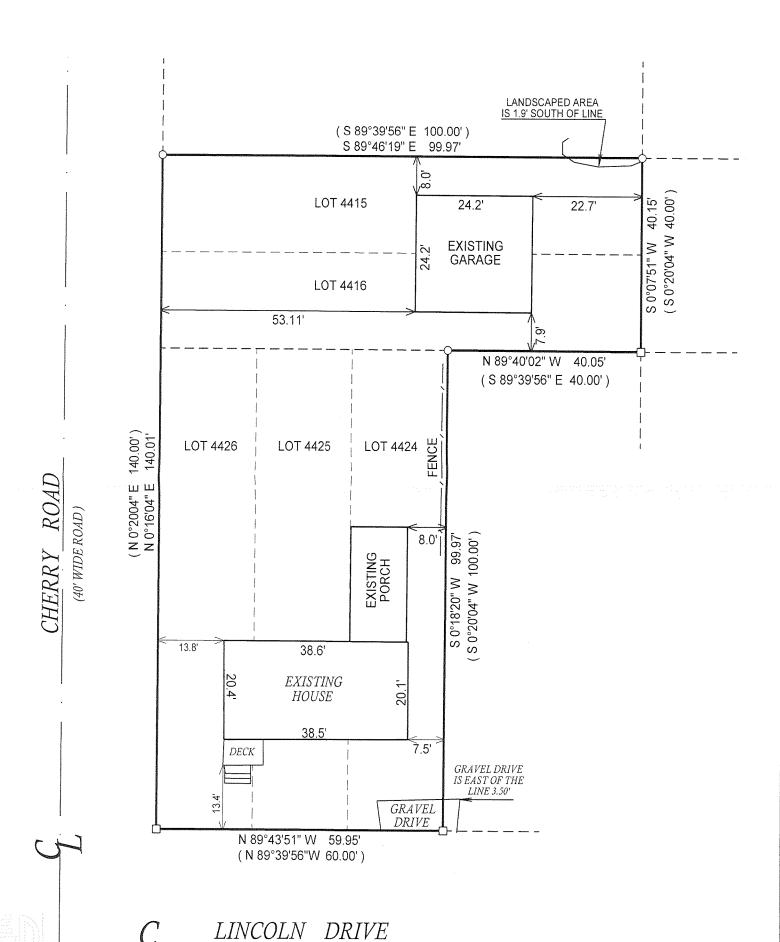

*LEGEND* 

FOUND IRON PIPE

AG 1 2 200

FOUND IRON BAR

(XX) RECORDED AS

JOB # 02-245AB TAX ID # JLCB8688865 DATED THIS THE 30th DAY OF MAY 2008.

"I hereby certify that I have surveyed the above described property and that the above map is a true representation thereof and shows the size and location of all visible structures, apparent easements and encroachments

(50' WIDE ROAD)

This survey is made for the present owners of the property, and those who purchase, mortgage, or guarentee the title thereto, within one year from the date hereof.



JOHN KROTT S - 2258

Wisconsin Registered Land Surveyor

( original if signed in red )

217-3504