
LAND-MARK SURVEYING Mark L. Miritz Wisconsin Registered Land Surveyor S-2582 SURVEY LOTS 5769 THROUGH 5775 INCLUSIVE, BLOCK 102, FIRST MAP OF LAKE COMO BEACH SUBDIVISION, LOCATED IN SECTIONS 21 AND 28, TOWN 2 NORTH, RANGE 17 EAST, GENEVA TOWNSHIP, WALWORTH COUNTY, WISCONSIN. **OWNERS: GENE L. DECKER** JUDITH A. DECKER N3072 BEGONIA ROAD LAKE GENEVA, WI. 53147

DEC 2 2 2008

"GCONS

MARKL MIRITZ S-2582

WHITEWATER.

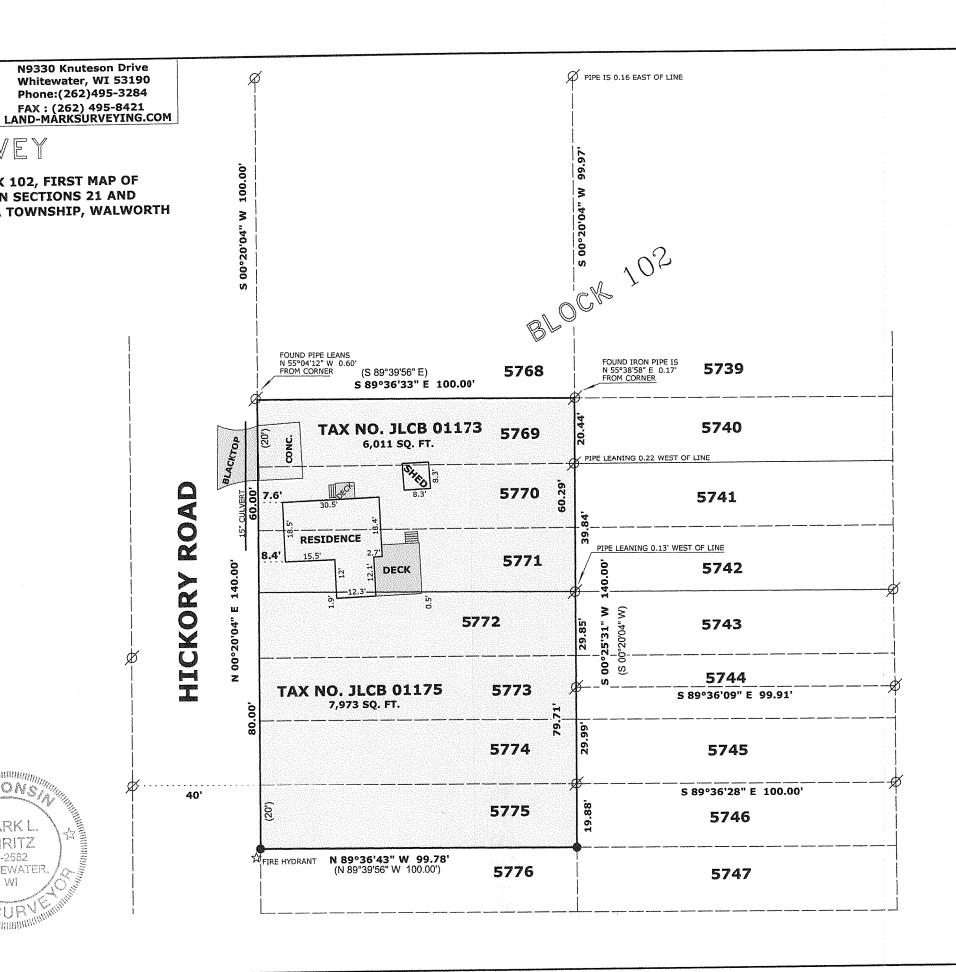

THE EAST LINE OF

LEGEND

FOUND IRON PIPE

SET IRON ROD, 24" LONG, WEIGHING 1.5 LBS./LINEAL FT., 3/4" DIA.

(xx)

RECORDED AS DIMENSION

OF HICKORY ROAD

WAS ASSUMED TO

AS PLATTED

BEAR N 00°20'04" E

SCALE: 1 INCH = 30 FEET

"I hereby certify that the above described property has been surveyed by me or under my direction and that the above map is a true representation thereof and shows the size and location of the property, its exterior boundaries, the location of all visible structures and dimensions of all principal buildings thereon, boundary fences, apparent easements, roadways and visible encroachments, if any."

"This survey is made for the use of the present owners of the property, and also those who purchase, mortgage, or guarantee the title thereto within one year from date hereof."

MARK L. MIRITZ WISCONSIN REGISTERED

LAND SURVEYOR S-2582

DATE: NOV. 18, 2008 JOB NO. <u>08.814</u>