

UNIT 3-06
JOHN & MARILYN BRIA

WORK ORDERED BY:
ALESCI HOMES, INC. - ANTHONY ALESCI
3044 SOUTH 92nd STREET
WEST ALLIS, WI 53227

FARRIS, HANSEN & ASSOCIATES, INC
Engineering, Architecture, Surveying
7 Ridgway Court P.O. Box 437
ELKHORN, WISCONSIN 53121
Office: (262) 723-2098
Fax: (262) 723-5886

REVISIONS
3/4/2009-KB
SITE, GRADING,
DRAINAGE, &
EROSION
CONTROL PLAN

PROJECT NO.
3269.03.06
DATE:
5/9/97
SHEET NO.
1 OF 1

PLAT OF SURVEY


UNIT 3-06 GENEVA NATIONAL CONDOMINIUM NO. 3

LOCATED IN TOWN 2 NORTH, RANGE 17 EAST WALWORTH COUNTY, WISCONSIN

3. The land referred to in the Commitment is described as follows:
Unit 3-06, together with said unit's undivided percentage interest in the common elements (and the exclusive use of the limited common elements appurtenant to said unit) all in Geneva National Condominium No. 3, a condominium declared and existing under and by virtue of the Condominium Ownership Act of the State of Wisconsin and recorded by a Declaration as such condominium in the Office of the Register of Deeds for Walworth County, Wisconsin, on June 26, 1991, Volume 524, Pages 855 through 907 inclusive, as Document No. 213817, said condominium being located in the Town of Geneva, County of Walworth, State of Wisconsin on the real estate described in said Declaration and incorporated herein by this reference thereto.
Tax Key No. JGN 300006

NOTE: PARTIAL EXPOSURE ON
NORTHEAST SIDE MAY BE MODIFIED
TO FILL UP TO TOP OF FOUNDATION
AT OWNERS OPTION.




- #### LEGEND
- = FOUND IRON REBAR STAKE
 - (XXX) = RECORDED AS
 - F.F. = FIRST FLOOR GRADE
 - T.F. = TOP OF FOUNDATION GRADE
 - G.E. = GARAGE ENTRY GRADE
 - BASE = BASEMENT GRADE

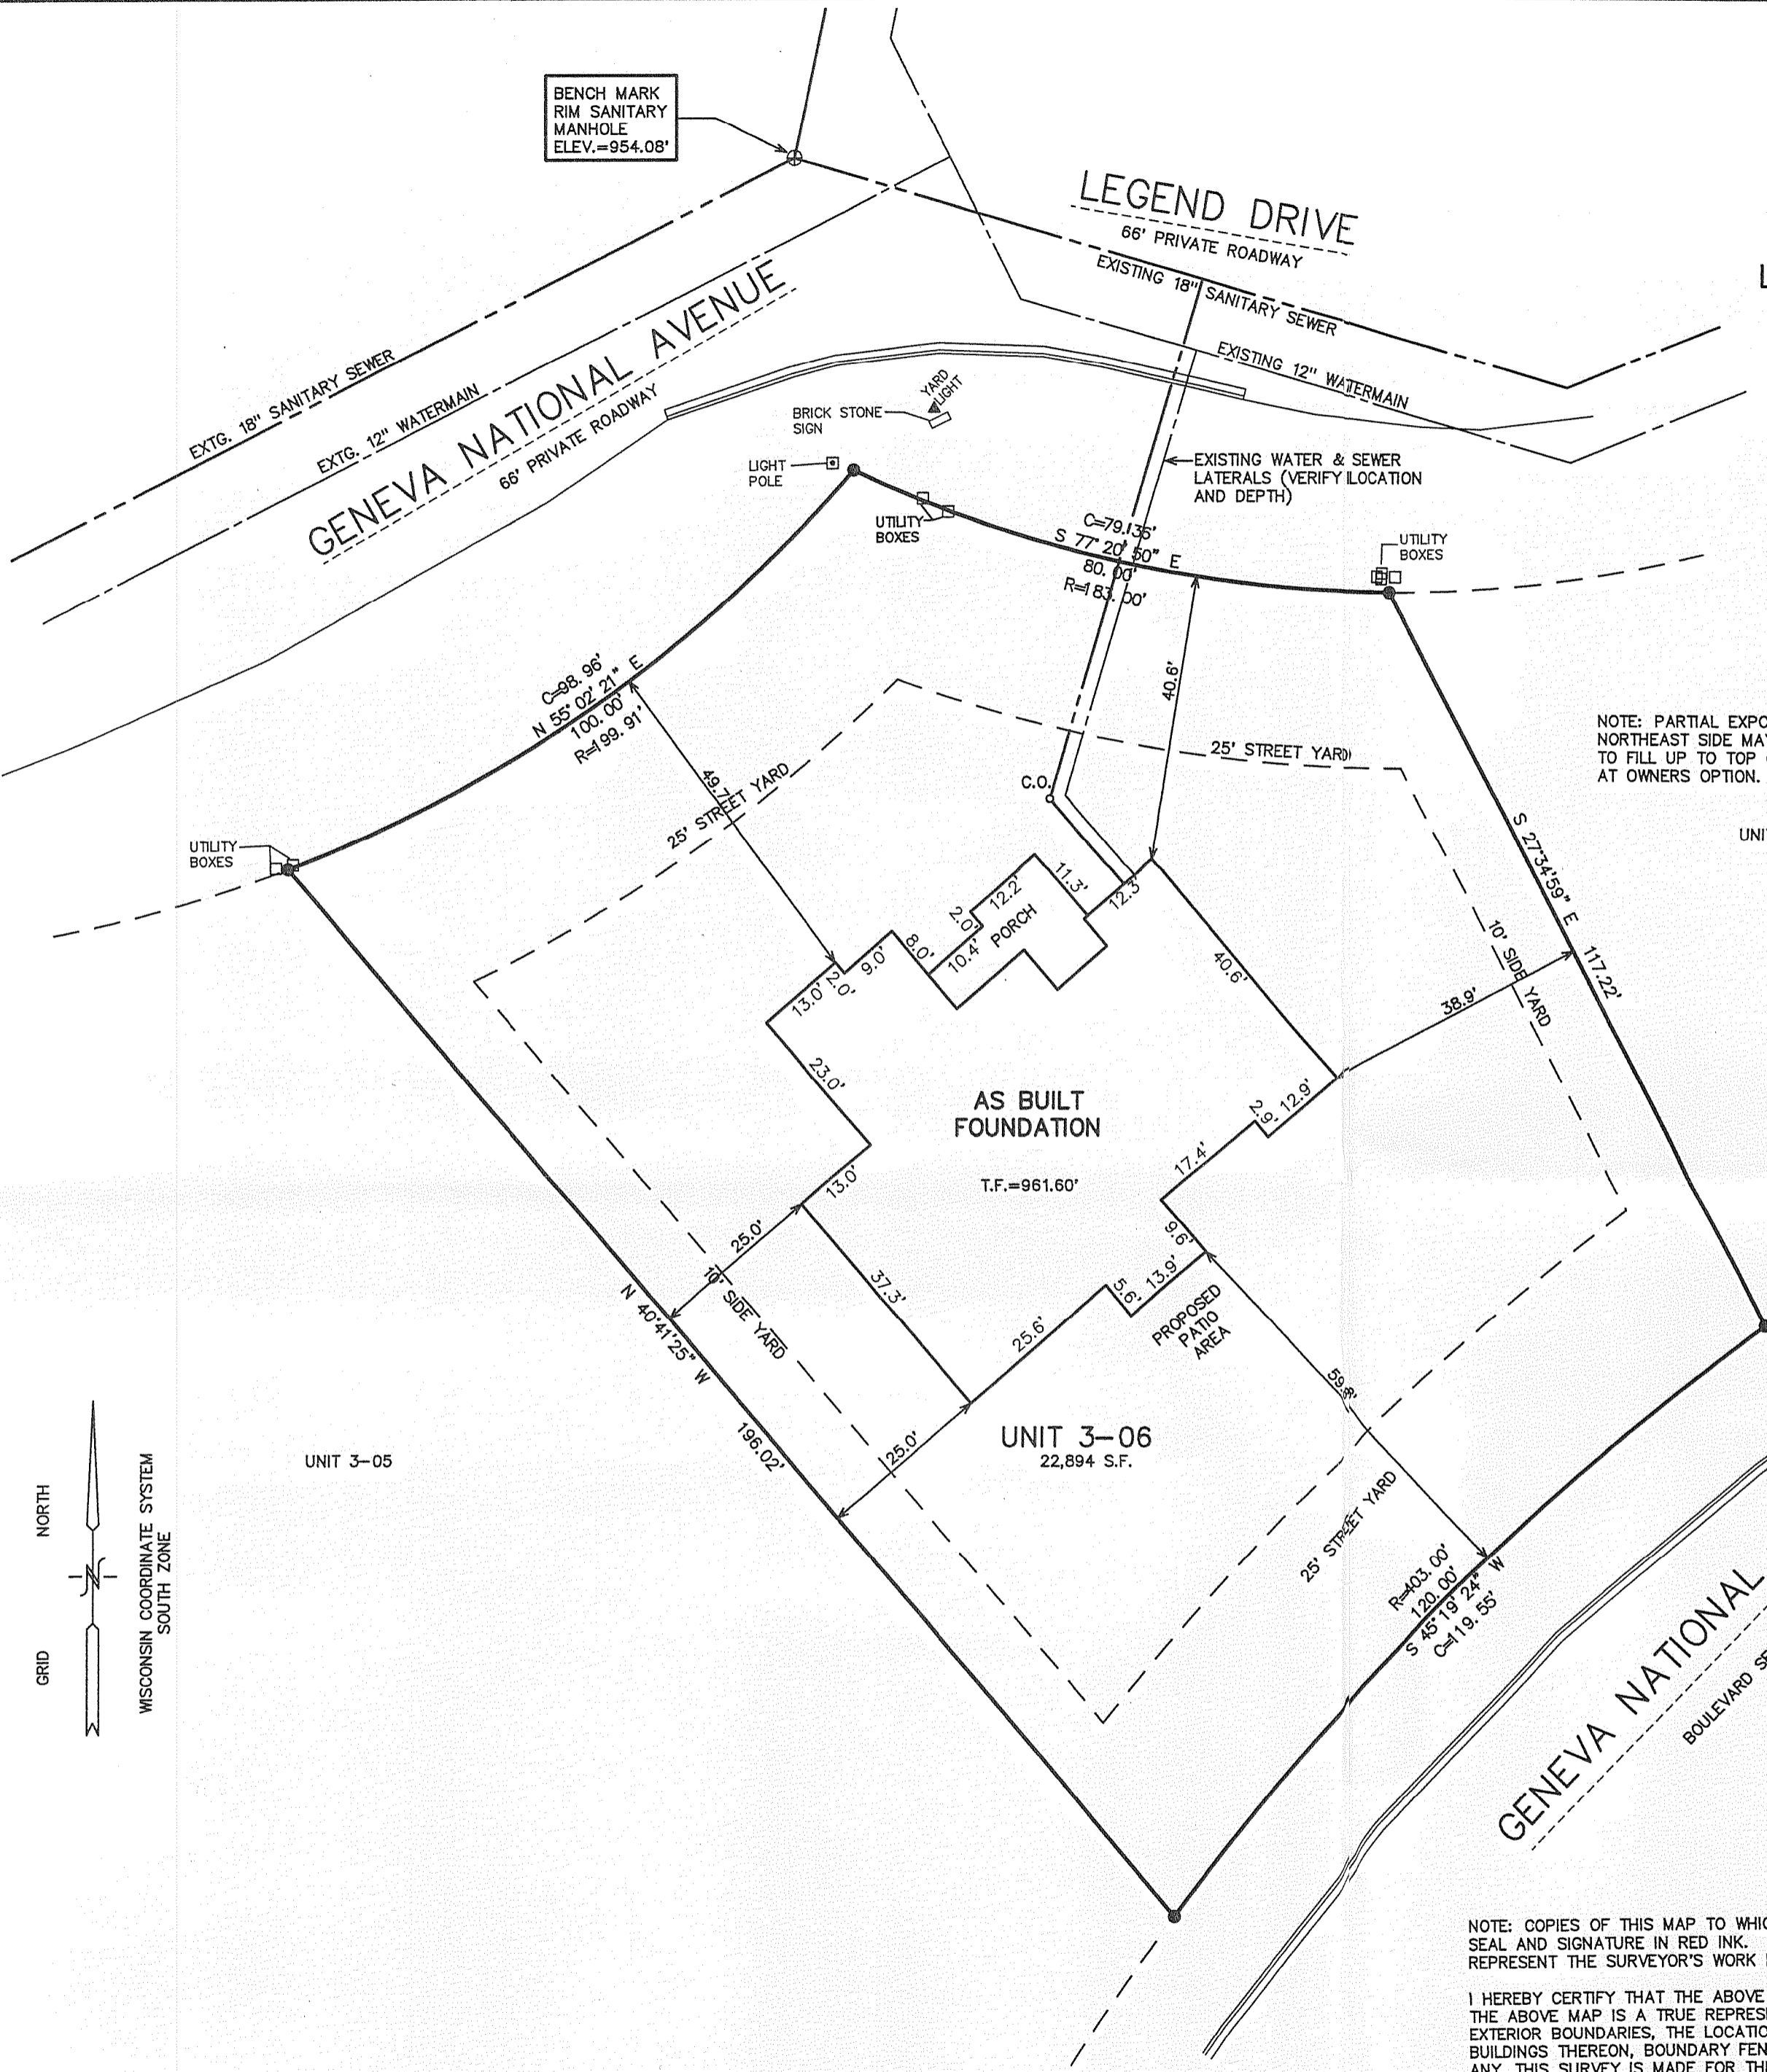

NOTE: COPIES OF THIS MAP TO WHICH THE FOLLOWING CERTIFICATE WILL APPLY SHOW SURVEYOR'S ORIGINAL SEAL AND SIGNATURE IN RED INK. COPIES BY ANY OTHER MEANS MAY HAVE ALTERATIONS WHICH DO NOT REPRESENT THE SURVEYOR'S WORK PRODUCT.

I HEREBY CERTIFY THAT THE ABOVE DESCRIBED PROPERTY HAS BEEN SURVEYED UNDER MY DIRECTION AND THAT THE ABOVE MAP IS A TRUE REPRESENTATION THEREOF AND SHOWS THE SIZE AND LOCATION OF THE PROPERTY, ITS EXTERIOR BOUNDARIES, THE LOCATION OF ALL VISIBLE STRUCTURES, AND DIMENSIONS OF ALL PRINCIPLE BUILDINGS THEREON, BOUNDARY FENCES, APPARENT EASEMENTS, ROADWAYS, AND VISIBLE ENCROACHMENTS, IF ANY. THIS SURVEY IS MADE FOR THE USE OF THE PRESENT OWNERS OF THE PROPERTY, AND ALSO THOSE WHO PURCHASE, MORTGAGE, OR GUARANTEE THE TITLE THERETO WITHIN ONE YEAR FROM THE DATE HEREOF.

DATED: FEBRUARY 17, 2009
REVISED 04-21-2009 TO SHOW AS BUILT FOUNDATION
SIZE & LOCATION & TOP OF FOUNDATION
Peter S. Gordon
PETER S. GORDON R.L.S. 2101

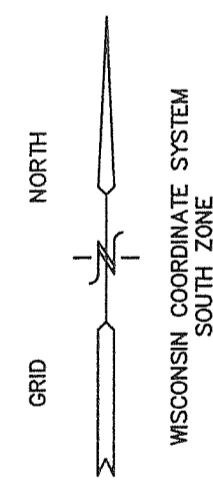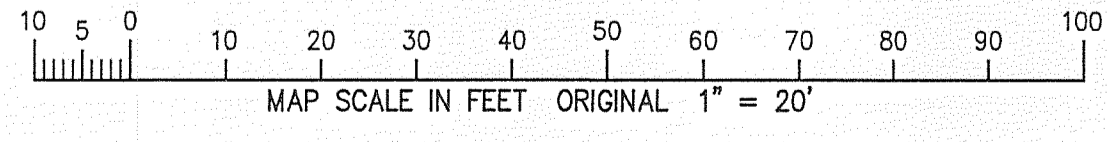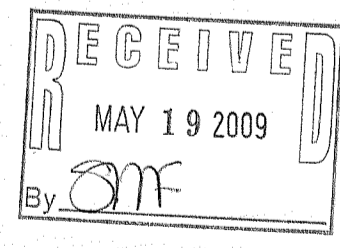

JGN 3-6

217-3557