PREPARED FOR NANCY SPRAGUE W3555 PARK DR. LAKE GENEVA WI. 53147


PLAT OF SURVEY

-OF-

LOTS 1524 THRU 1528 BLOCK 25, LAKE COMO BEACH SUBDIVISION LOCATED IN TOWN 2 NORTH, RANGE 17 EAST, WALWORTH COUNTY, WISCONSIN.

KROTT SURVEYING INC. N3705 WILLOW BEND LANE

N3705 WILLOW BEND LAN LAKE GENEVA WI. 53147 PHONE # (262)248-3697 FAX # (262)249-0639

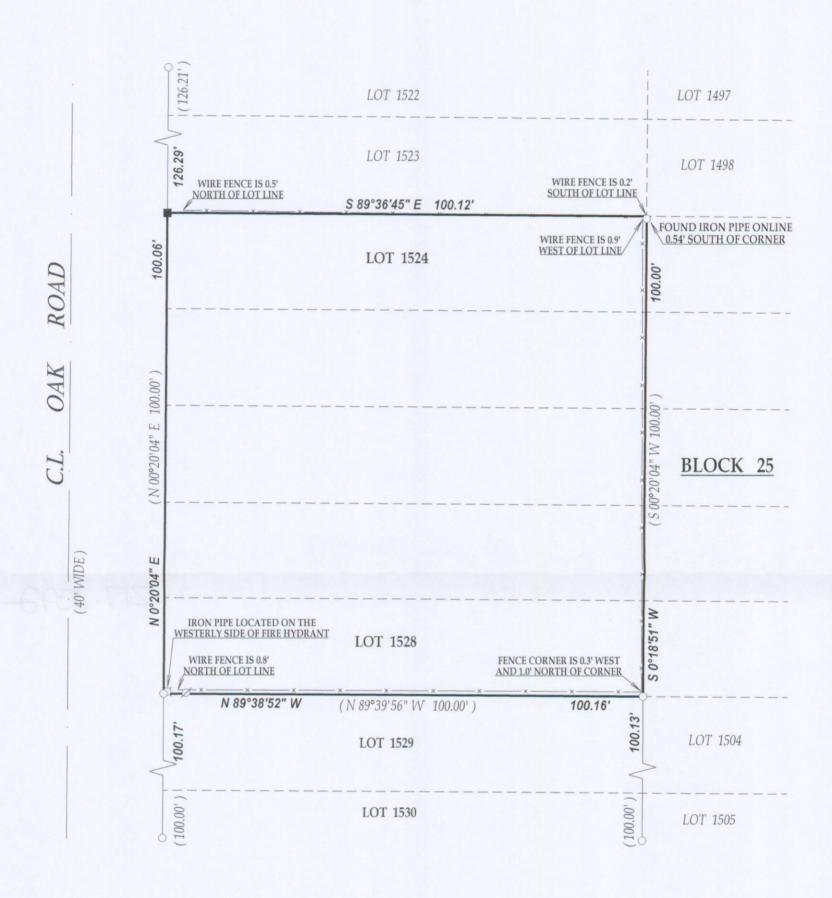



LEGEND

- O FOUND IRON PIPE
- SET IRON BAR
- Ø UTILITY POLE

(XX) RECORDED AS TAXID # JLCB00232 JOB # 09-137




SCALE 1" = 20'

NOTE: BASIS OF BEARINGS ARE REFRENCED TO THE PLAT OF LAKE COMO BEACH SUBDIVISION.

I have surveyed the above-described property and the above map is a true representation thereof and shows the size and location of the property, its exterior boundaries, the location and dimensions of all structures thereon, fences apparent easements and roadways and visible encroachments. if any.

This survey is made for the exclusive use of the present owners of the property, and also those who puchase, mortgage, or insure the title therto within one (1) year from date hereof; and as to them I warrant the accuracy of said survey map.

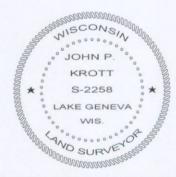

DATED THIS 30th DAY OF SEPTEMBER 2009.

JOHN KROTT S - 2258 Wisconsin Registered Land Surveyor (original if signed in red)

217-3592