


HOLLAND & THOMAS, L.L.C. - LAND SURVEYORS

202 West Street Johnson Creek, WI 53038 (920) 699-3305

PLAT OF SURVEY

FOR LOT 5 OF PAPPAS SUBDIVISION, AND BEING A PART OF THE NW 1/4 OF THE SOUTHWEST QUARTER OF SECTION 34, TOWN 2 NORTH, RANGE 17 EAST, TOWN OF GENEVA, WALWORTH COUNTY, WISCONSIN.

**SURVEYOR'S MEETS AND BOUNDS DESCRIPTION:**  
 BEGINNING AT THE SOUTHERN-MOST CORNER OF SAID LOT 5, THE SAME BEING THE SOUTHEAST CORNER OF LOT 2 OF CERTIFIED SURVEY MAP NO. 1389; THENCE NORTH 14°-23'-39" WEST, ALONG THE COMMON BOUNDARY BETWEEN SAID LOT 5 AND SAID LOT 2, 105.90 FEET TO THE NORTHEAST CORNER OF SAID LOT 2 AND THE EAST RIGHT-OF-WAY LINE OF A 60' WIDE PRIVATE DRIVE RECORDED AS OUTLOT 2 OF SAID CERTIFIED SURVEY MAP NO. 1389; THENCE NORTH 00°-51'-23" WEST, ALONG THE COMMON BOUNDARY BETWEEN SAID LOT 5 AND SAID OUTLOT 2, 408.78 FEET TO THE NORTHWEST CORNER OF SAID LOT 5 AND THE SOUTHWEST CORNER OF LOT 4 OF SAID PAPPAS SUBDIVISION; THENCE NORTH 89°-23'-29" EAST, ALONG THE COMMON BOUNDARY BETWEEN SAID LOT 5 AND SAID LOT 4, 149.92 FEET TO THE NORTHEAST CORNER OF SAID LOT 5 AND THE SOUTHWEST CORNER OF SAID LOT 4; THENCE SOUTH 00°-52'-21" EAST, ALONG THE EAST BOUNDARY OF SAID LOT 5, 478.76 FEET TO THE SOUTHEAST CORNER OF SAID LOT 5; THENCE SOUTH 74°-40'-24" WEST, ALONG THE SOUTH BOUNDARY OF SAID LOT 5, 129.37 FEET TO THE POINT OF BEGINNING.

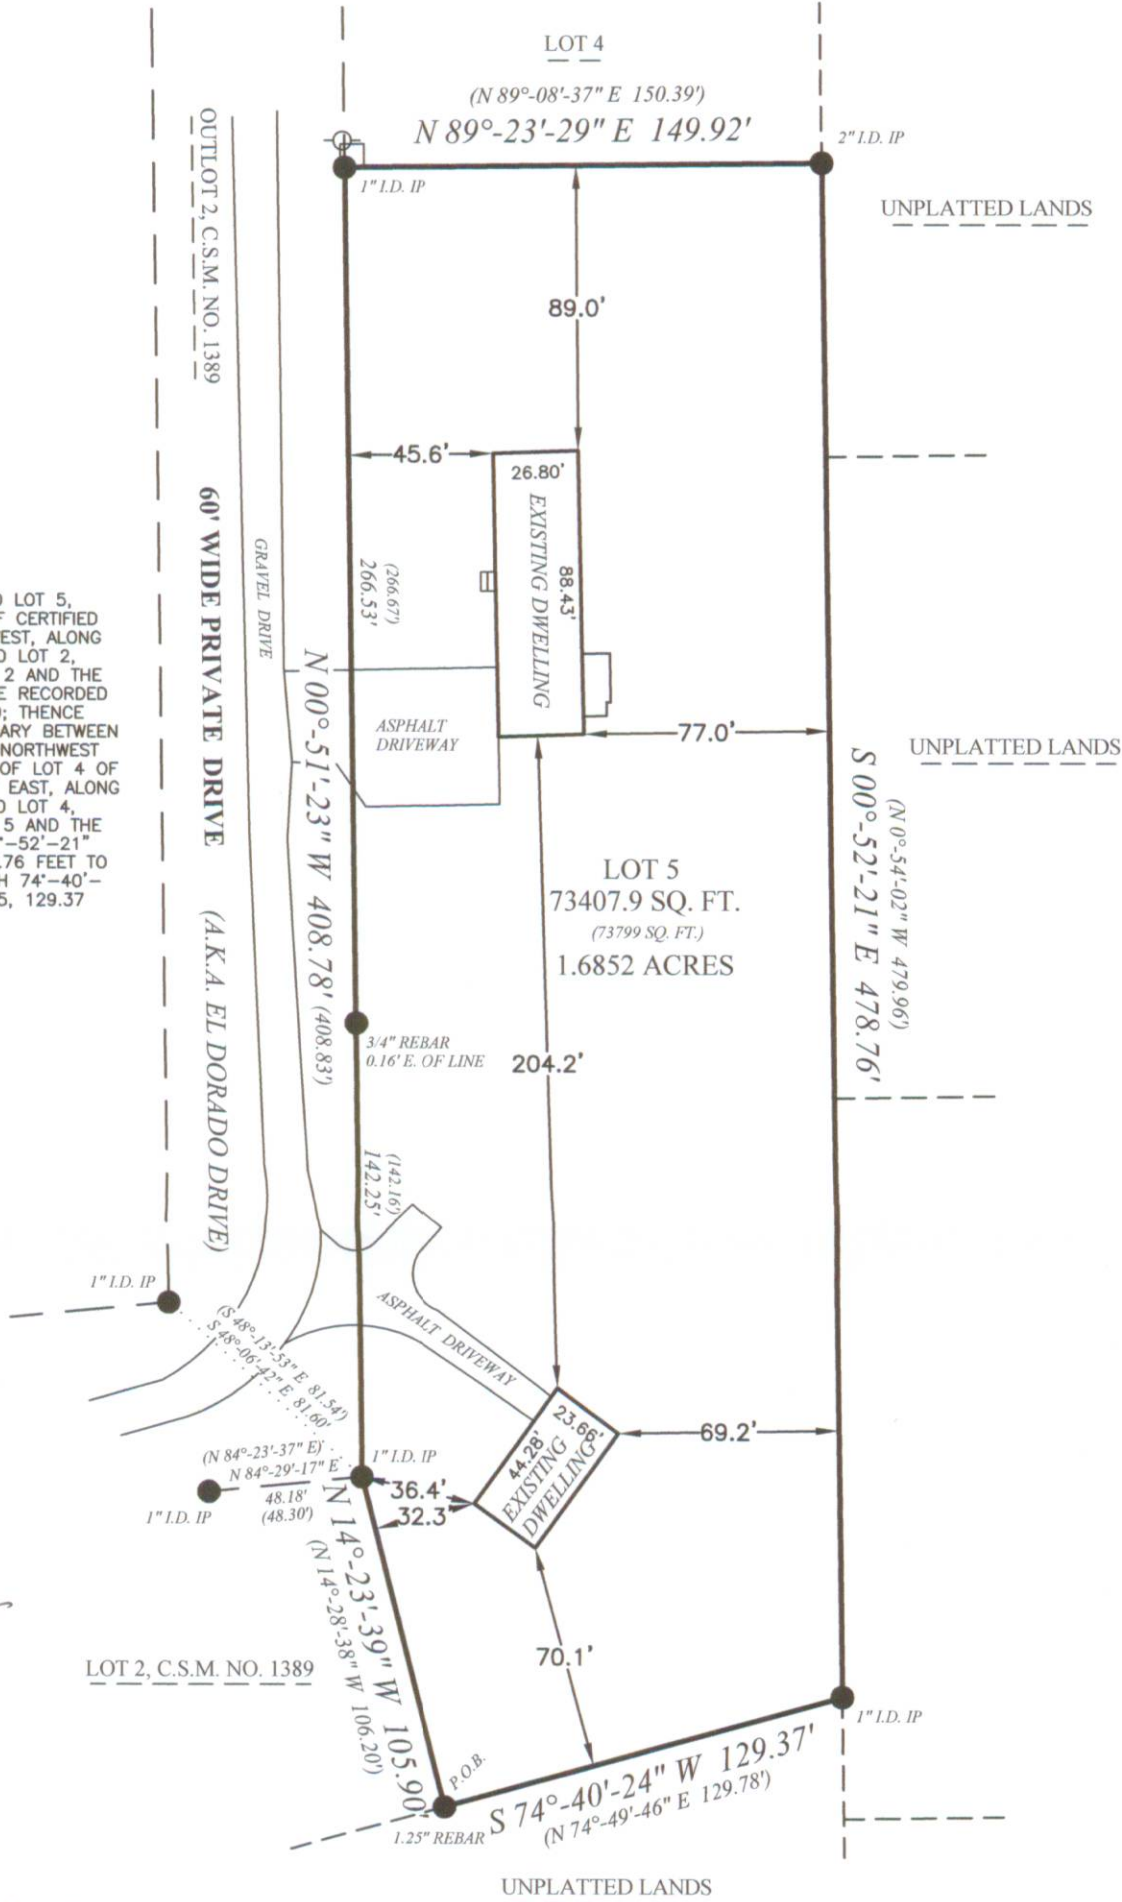

IF THE SURVEYOR'S SEAL IS NOT RED, THE PLAN IS A COPY THAT SHOULD BE ASSUMED TO CONTAIN UNAUTHORIZED ALTERATIONS. THE CERTIFICATION CONTAINED ON THIS DOCUMENT DOES NOT APPLY TO COPIES UNLESS THEY TOO HAVE A RED STAMP OVER THE PHOTOCOPIED STAMP BY SAME SURVEYOR.

State of Wisconsin } SS.  
 County of Jefferson }


We, Holland & Thomas, L.L.C., do hereby certify that we have made this survey and that the information as shown on the above Plat of Survey is a true and correct representation thereof. Lots are drawn from subdivision plats or C.S.M.s; unplatted lands from recorded deeds/surveys. Boundary survey plats reflect field-located information; consult a title attorney to discover all the legal encumbrances attached to any property.

BEARINGS ARE REFERENCED TO THE WEST LINE OF LOT 5, SHOWN HEREON, AS FOUND MONUMENTED, WHICH IS ASSUMED TO BEAR N 00°-51'-23" W.



**LEGEND:** These standard symbols may be found in the drawing.

- Lot Corner (Found) w/desc.
- Elec. Trans. Box
- Utility Pedestal
- (") "Recorded As" Information

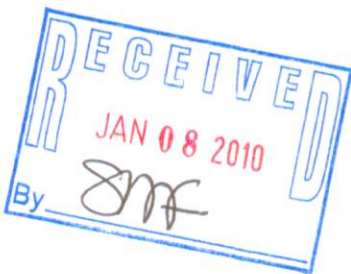

OWNER: JOHN PAPPAS  
 N2468 EL DORADO DR.  
 LAKE GENEVA, WI 53147

PREPARED FOR: DAMAGE CONTROL, INC.  
 3303 W. NATIONAL AVE.  
 MILWAUKEE, WI 53215  
 PH: 1-800-716-2565  
 FAX: (414) 672-3409  
 www.damage-control.com