

PREPARED FOR
 JULIE SARTON
 KEEFE REAL ESTATE
 751 GENEVA PARKWAY
 LAKE GENEVA WI. 53147

PLAT OF SURVEY


-OF-

LOTS 23 THRU 26 OF GUMMOW ADDITION LOCATED IN THE
 SOUTHEAST 1/4 OF THE NORTHWEST 1/4 OF SECTION 25, TOWN
 2 NORTH, RANGE 17 EAST, WALWORTH COUNTY, WISCONSIN.

KROTT SURVEYING INC.

N3705 WILLOW BEND LANE
 LAKE GENEVA WI. 53147
 PHONE # (262)248-3697
 FAX # (262)249-0639



C.L. WILLIAMS STREET
 (50' WIDE)

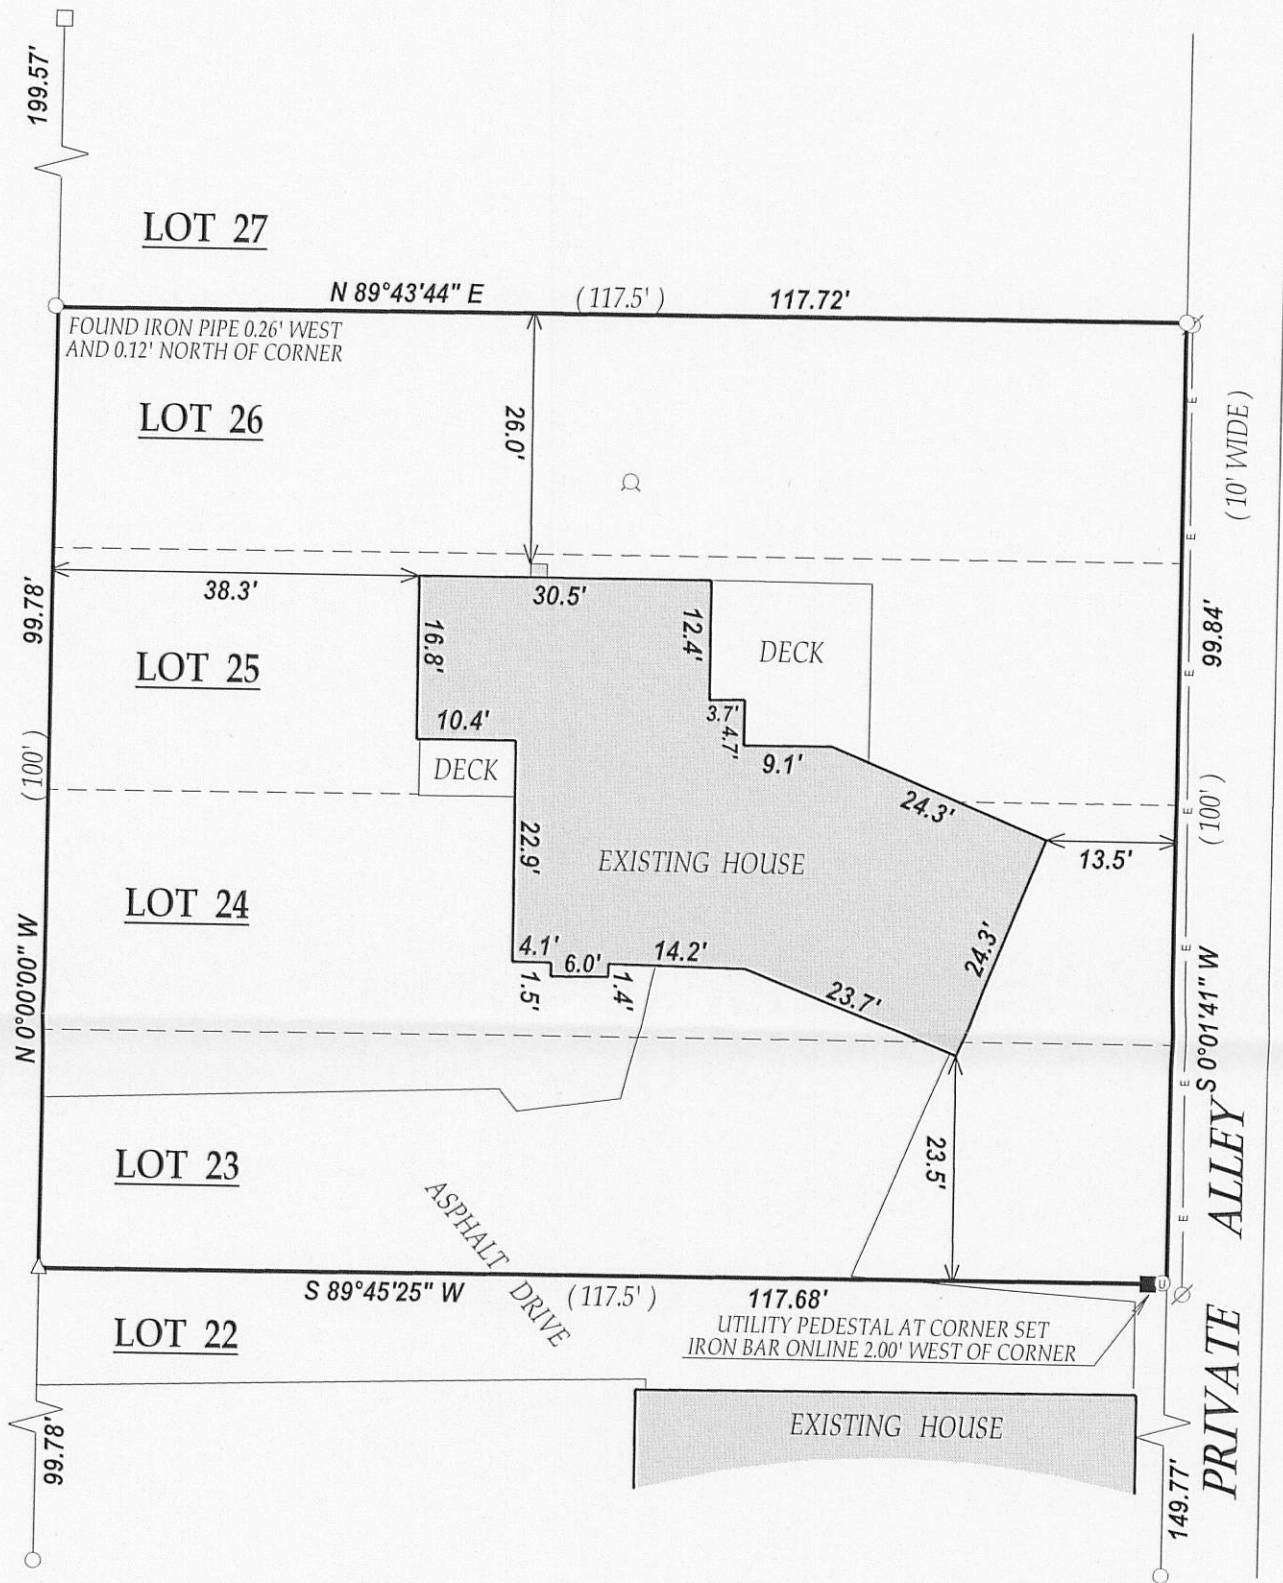

RECEIVED
 APR 08 2010
 By *JMF*

LEGEND


- FOUND IRON PIPE
- FOUND IRON BAR
- SET IRON BAR
- △ SET MAG NAIL
- WELL
- ⊗ UTILITY POLE
- E— OVERHEAD WIRES

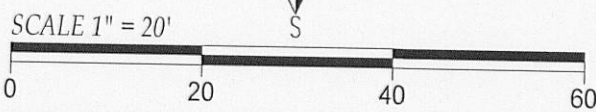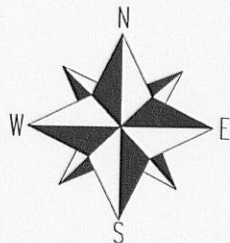

NOTE: BASIS OF BEARING IS THE EAST LINE OF WILLIAMS STREET AND WAS ASSUMED TO BEAR N00°00'00" W

I have surveyed the above-described property and the above map is a true representation thereof and shows the size and location of the property, its exterior boundaries, the location and dimensions of all structures thereon, fences apparent easements and roadways and visible encroachments, if any.

This survey is made for the exclusive use of the present owners of the property, and also those who purchase, mortgage, or insure the title thereto within one (1) year from date hereof; and as to them I warrant the accuracy of said survey map.

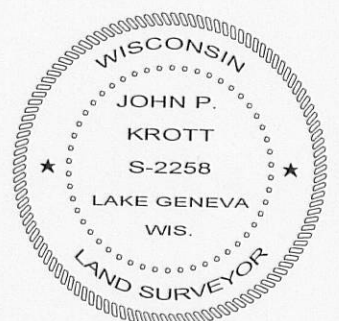

DATED THIS 8th DAY OF FEBRUARY 2010.

John P. Krott

JOHN KROTT S - 2258
 Wisconsin Registered Land Surveyor
 (original if signed in red)

(XX) RECORDED AS
 TAX ID # JGUM00007
 JOB # 10-023

217 - 2107