
PREPARED FOR DIANE COCROFT KEEFE REAL ESTATE 751 GENEVA PARKWAY LAKE GENEVA WI. 53147

PLAT OF SURVEY

-OF-

LOTS 7884 THRU 7887 AND THE NORTH 1/2 OF LOT 7888 BLOCK 134 OF LAKE COMO BEACH SUBDIVISION, LOCATED IN SECTION 28, TOWN 2 NORTH, RANGE 17 EAST, WALWORTH COUNTY, WISCONSIN. KROTT SURVEYING INC.

N3705 WILLOW BEND LANE LAKE GENEVA WI. 53147 PHONE # (262)248-3697 FAX # (262)249-0639

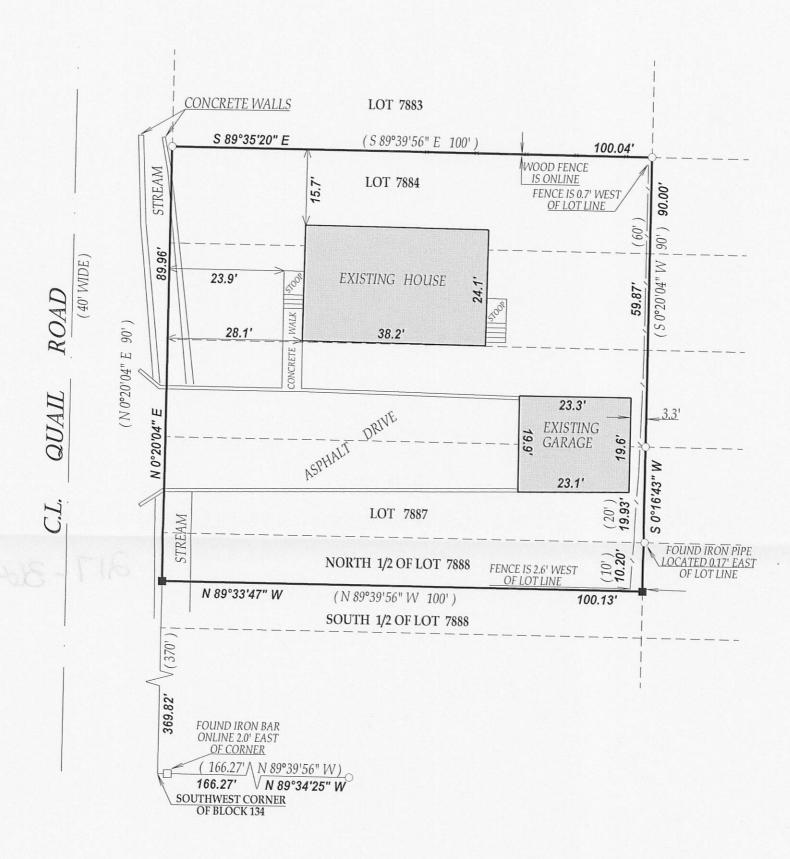




LEGEND

- O FOUND IRON PIPE
- ☐ FOUND IRON BAR
- SET IRON BAR

(XX) RECORDED AS TAX ID # JLCB01678 JOB # 10-081

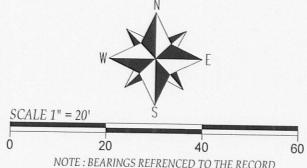

NOTE: BEARINGS REFRENCED TO THE RECORD PLAT OF LAKE COMO BEACH SUBDIVISION

I have surveyed the above-described property and the above map is a true representation thereof and shows the size and location of the property, its exterior boundaries, the location and dimensions of all structures thereon, fences apparent easements and roadways and visible encroachments. if any.

This survey is made for the exclusive use of the present owners of the property, and also those who puchase, mortgage, or insure the title therto within one (1) year from date hereof; and as to them I warrant the accuracy of said survey map.



DATED THIS 6th DAY OF MAY 2010.

JOHN KROTT S - 2258 Wisconsin Registered Land Surveyor (original if signed in red)

277 201