

PLAT OF SURVEY

- OF -


LOTS 8774-8779 BLOCK 152 OF LAKE COMO BEACH SUBDIVISION; LOCATED IN TOWN 2 NORTH, RANGE 17 EAST, WALWORTH COUNTY, WISCONSIN PATHFINDER SURVEYING INC. (formerly) J.K. SURVEYING INC. P.O. BOX 322 LAKE GENEVA, WI. 262-248-8303

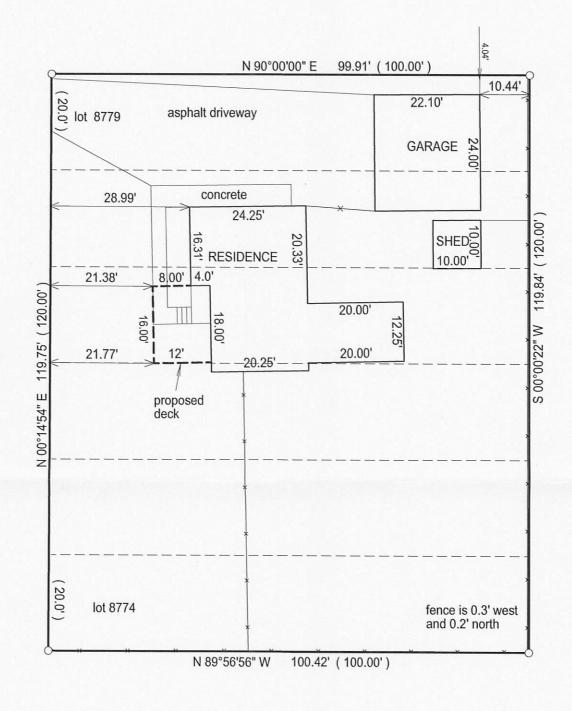

CHERRY ROAD (PLATTED AS 40' WIDE)

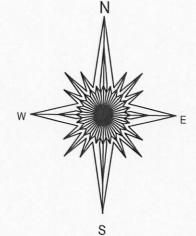

BASIS OF BEARING OF THIS PLAT: CHERRY ROAD WAS ASSUMED TO BEAR NORTH - SOUTH.

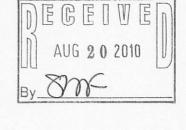

()= recorded as

□ = found iron bar

= found iron pipe

= set iron pipe

= set iron bar

SCALE 1" = 20'

JOB # 10-67

TAX ID #
JLCB 01883

"I hereby certify that I have surveyed the above described property and that the above map is a true representation of its exterior boundary and shows the size and location of all visible structures, apparent easements and encroachments if any."

This survey is made for the present owners of the property, and those who purchase, mortgage, or guarantee the title thereto, within one year from the date hereof.

DATED THIS 10TH DAY OF MAY, 2010.



JEFFREY L KIMPS S - 2436 Wisconsin Registered Land Surveyor (original if signed in red)

217 2/50