

PREPARED FOR:  
DIANE COCROFT  
KEEFE REALTY  
751 GENEVA PARKWAY  
LAKE GENEVA WI 53147

# PLAT OF SURVEY

-OF-

LOTS 7207 THRU 7211 AND LOTS 7175 THRU 7179  
BLOCK 123 OF LAKE COMO BEACH SUBDIVISION,  
LOCATED INTOWN 2 NORTH, RANGE 16 EAST,  
WALWORTH COUNTY, WISCONSIN.





KROTT SURVEYING INC.

N3705 WILLOW BEND LANE

LAKE GENEVA WI. 53147

PHONE # (262)248-3697

FAX # (262)249-0639

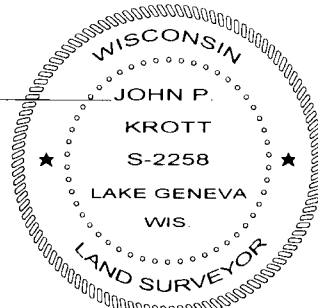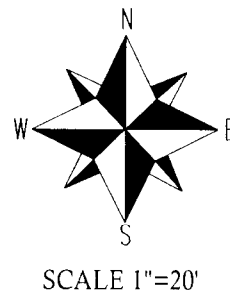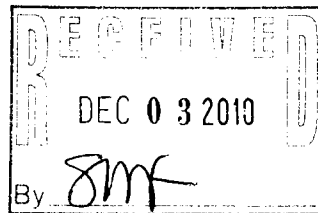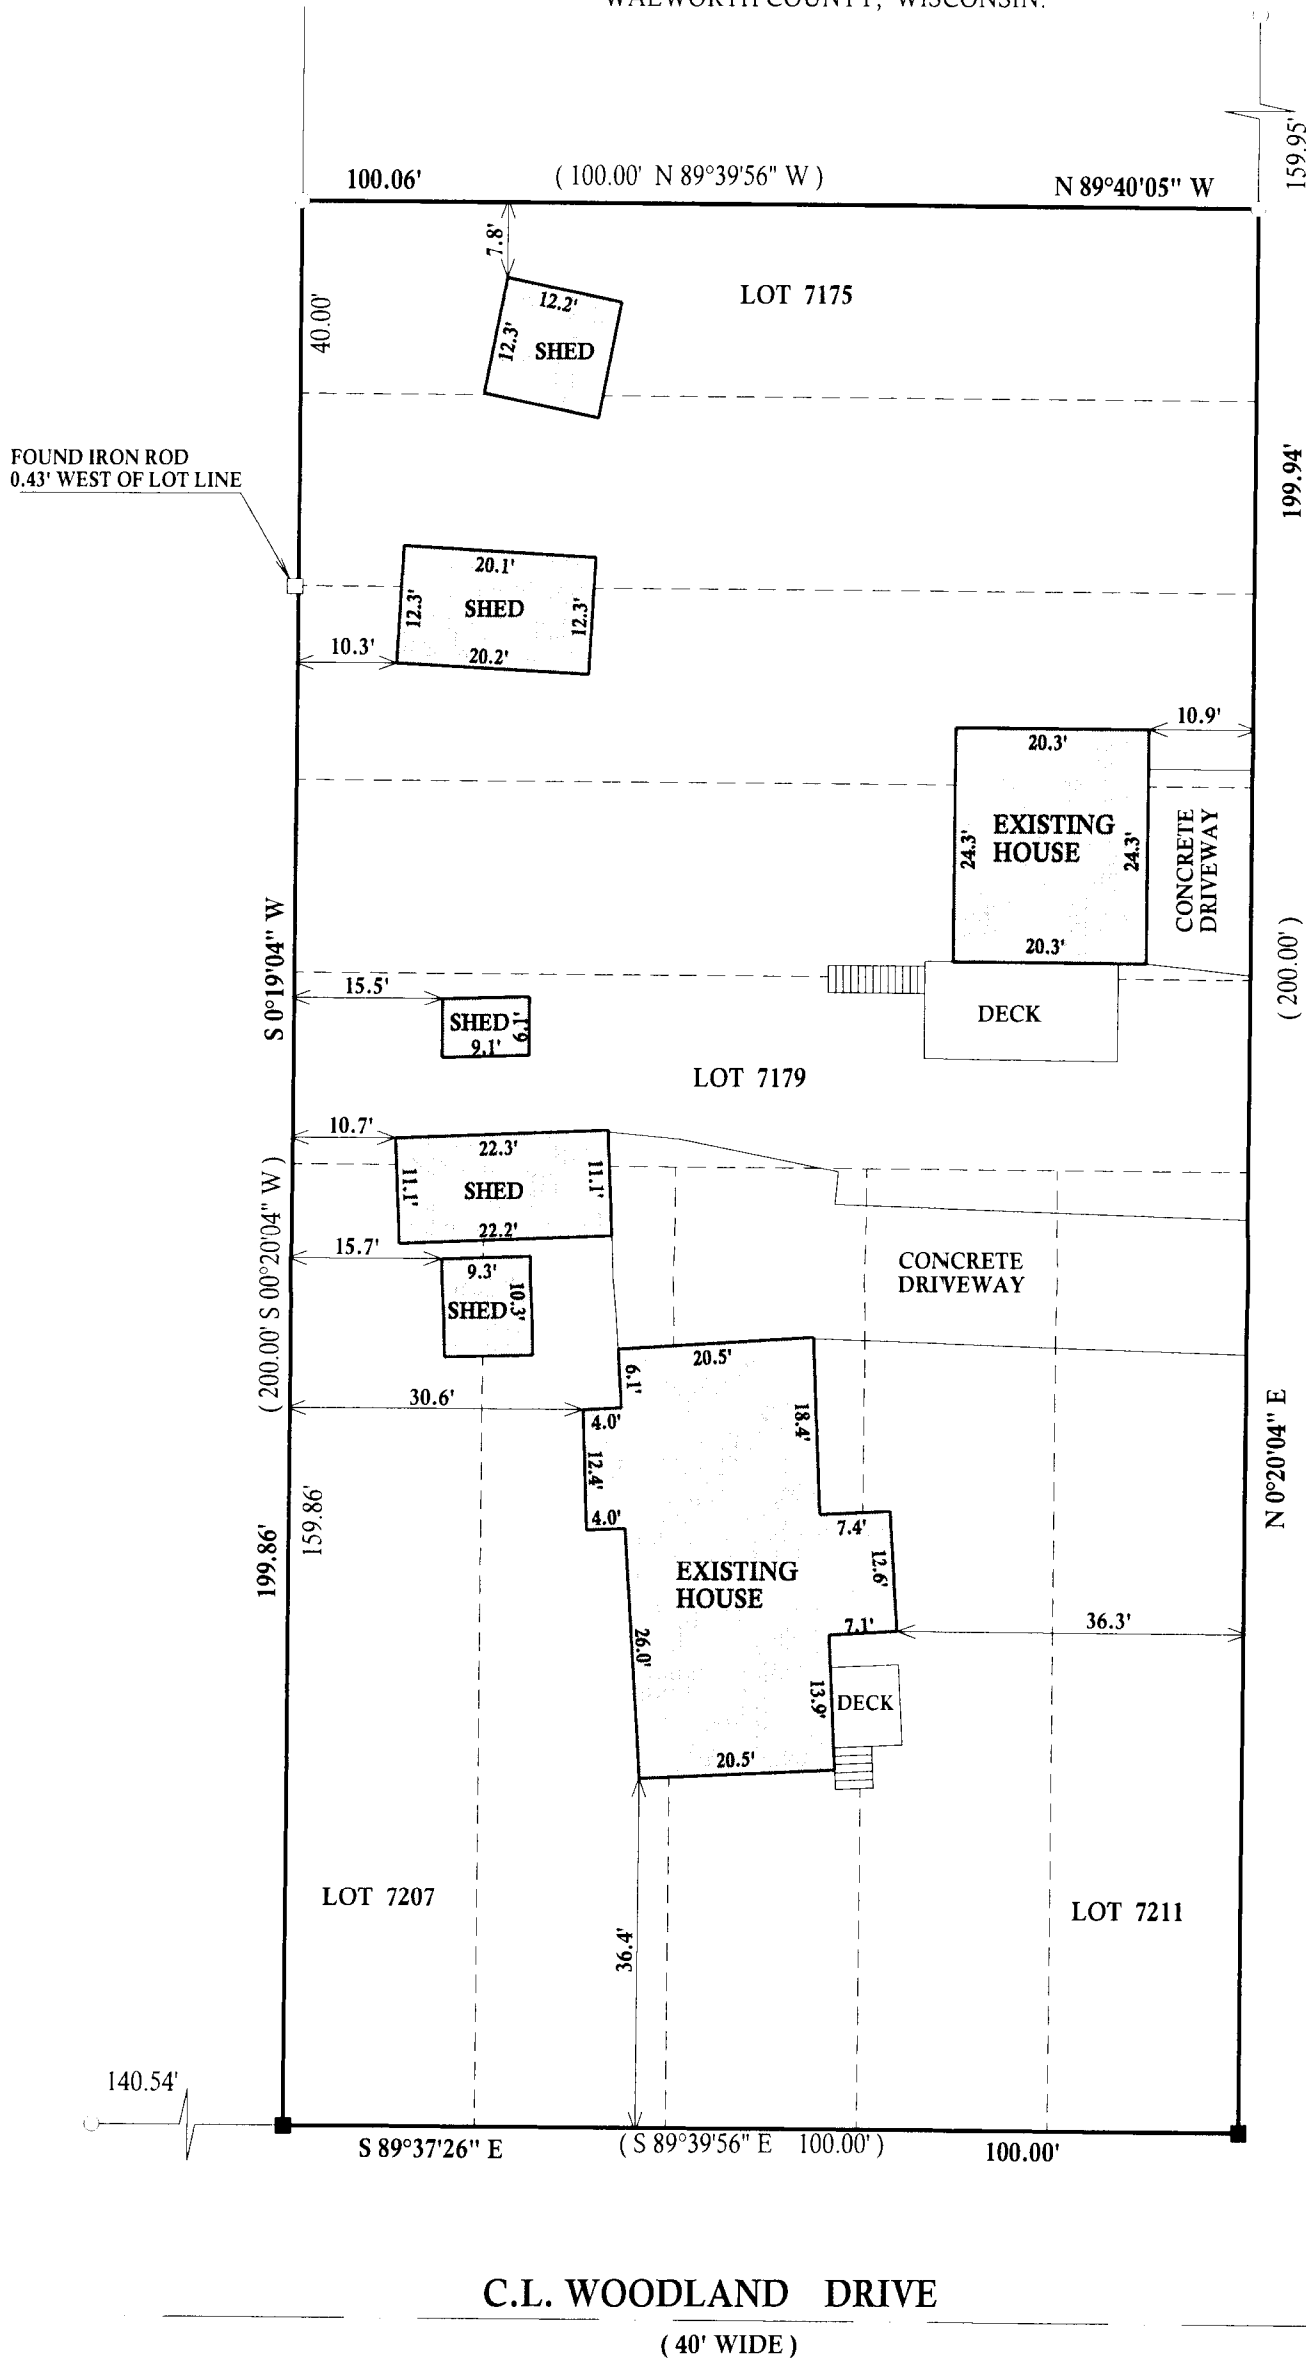

DATED THIS 18th, DAY OF NOVEMBER, 2010

*John P. Krott*

JOHN KROTT S - 2258  
Wisconsin Registered Land Surveyor  
(original if signed in red)

## LEGEND

- FOUND IRON PIPE
- FOUND IRON BAR
- SET IRON BAR
- (xx) RECORDED AS

BEARINGS REFERENCED TO THE RECORD  
PLAT OF LAKE COMO BEACH

I have surveyed the above-described property and the above map is a true representation thereof and shows the size and location of the property, its exterior boundaries, the location and dimensions of all structures thereon, fences apparent easements and roadways and visible encroachments, if any.

This survey is made for the exclusive use of the present owners of the property, and also those who purchase, mortgage, or insure the title thereto within one (1) year from date hereof; and as to them I warrant the accuracy of said survey map.

JOB # 10-183 TAX ID # JLCB01522

217 2183