

PREPARED FOR  
JENNIE SWANSON  
1715 EVERGREEN  
HANOVER PARK IL. 60629



PLAT OF SURVEY

-OF-

KROTT SURVEYING INC.

N3705 WILLOW BEND LANE  
LAKE GENEVA WI. 53147  
PHONE # (262)248-3697  
FAX # (262)249-0639

LOTS 11408 THRU 11412 BLOCK 205, OF THE 5th MAP OF LAKE COMO BEACH SUBDIVISION  
LOCATED IN SECTION 29, TOWN 2 NORTH, RANGE 17 EAST WALWORTH COUNTY, WISCONSIN.

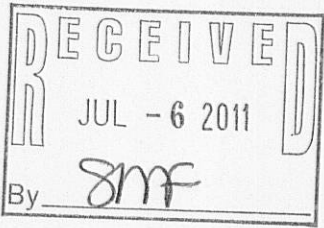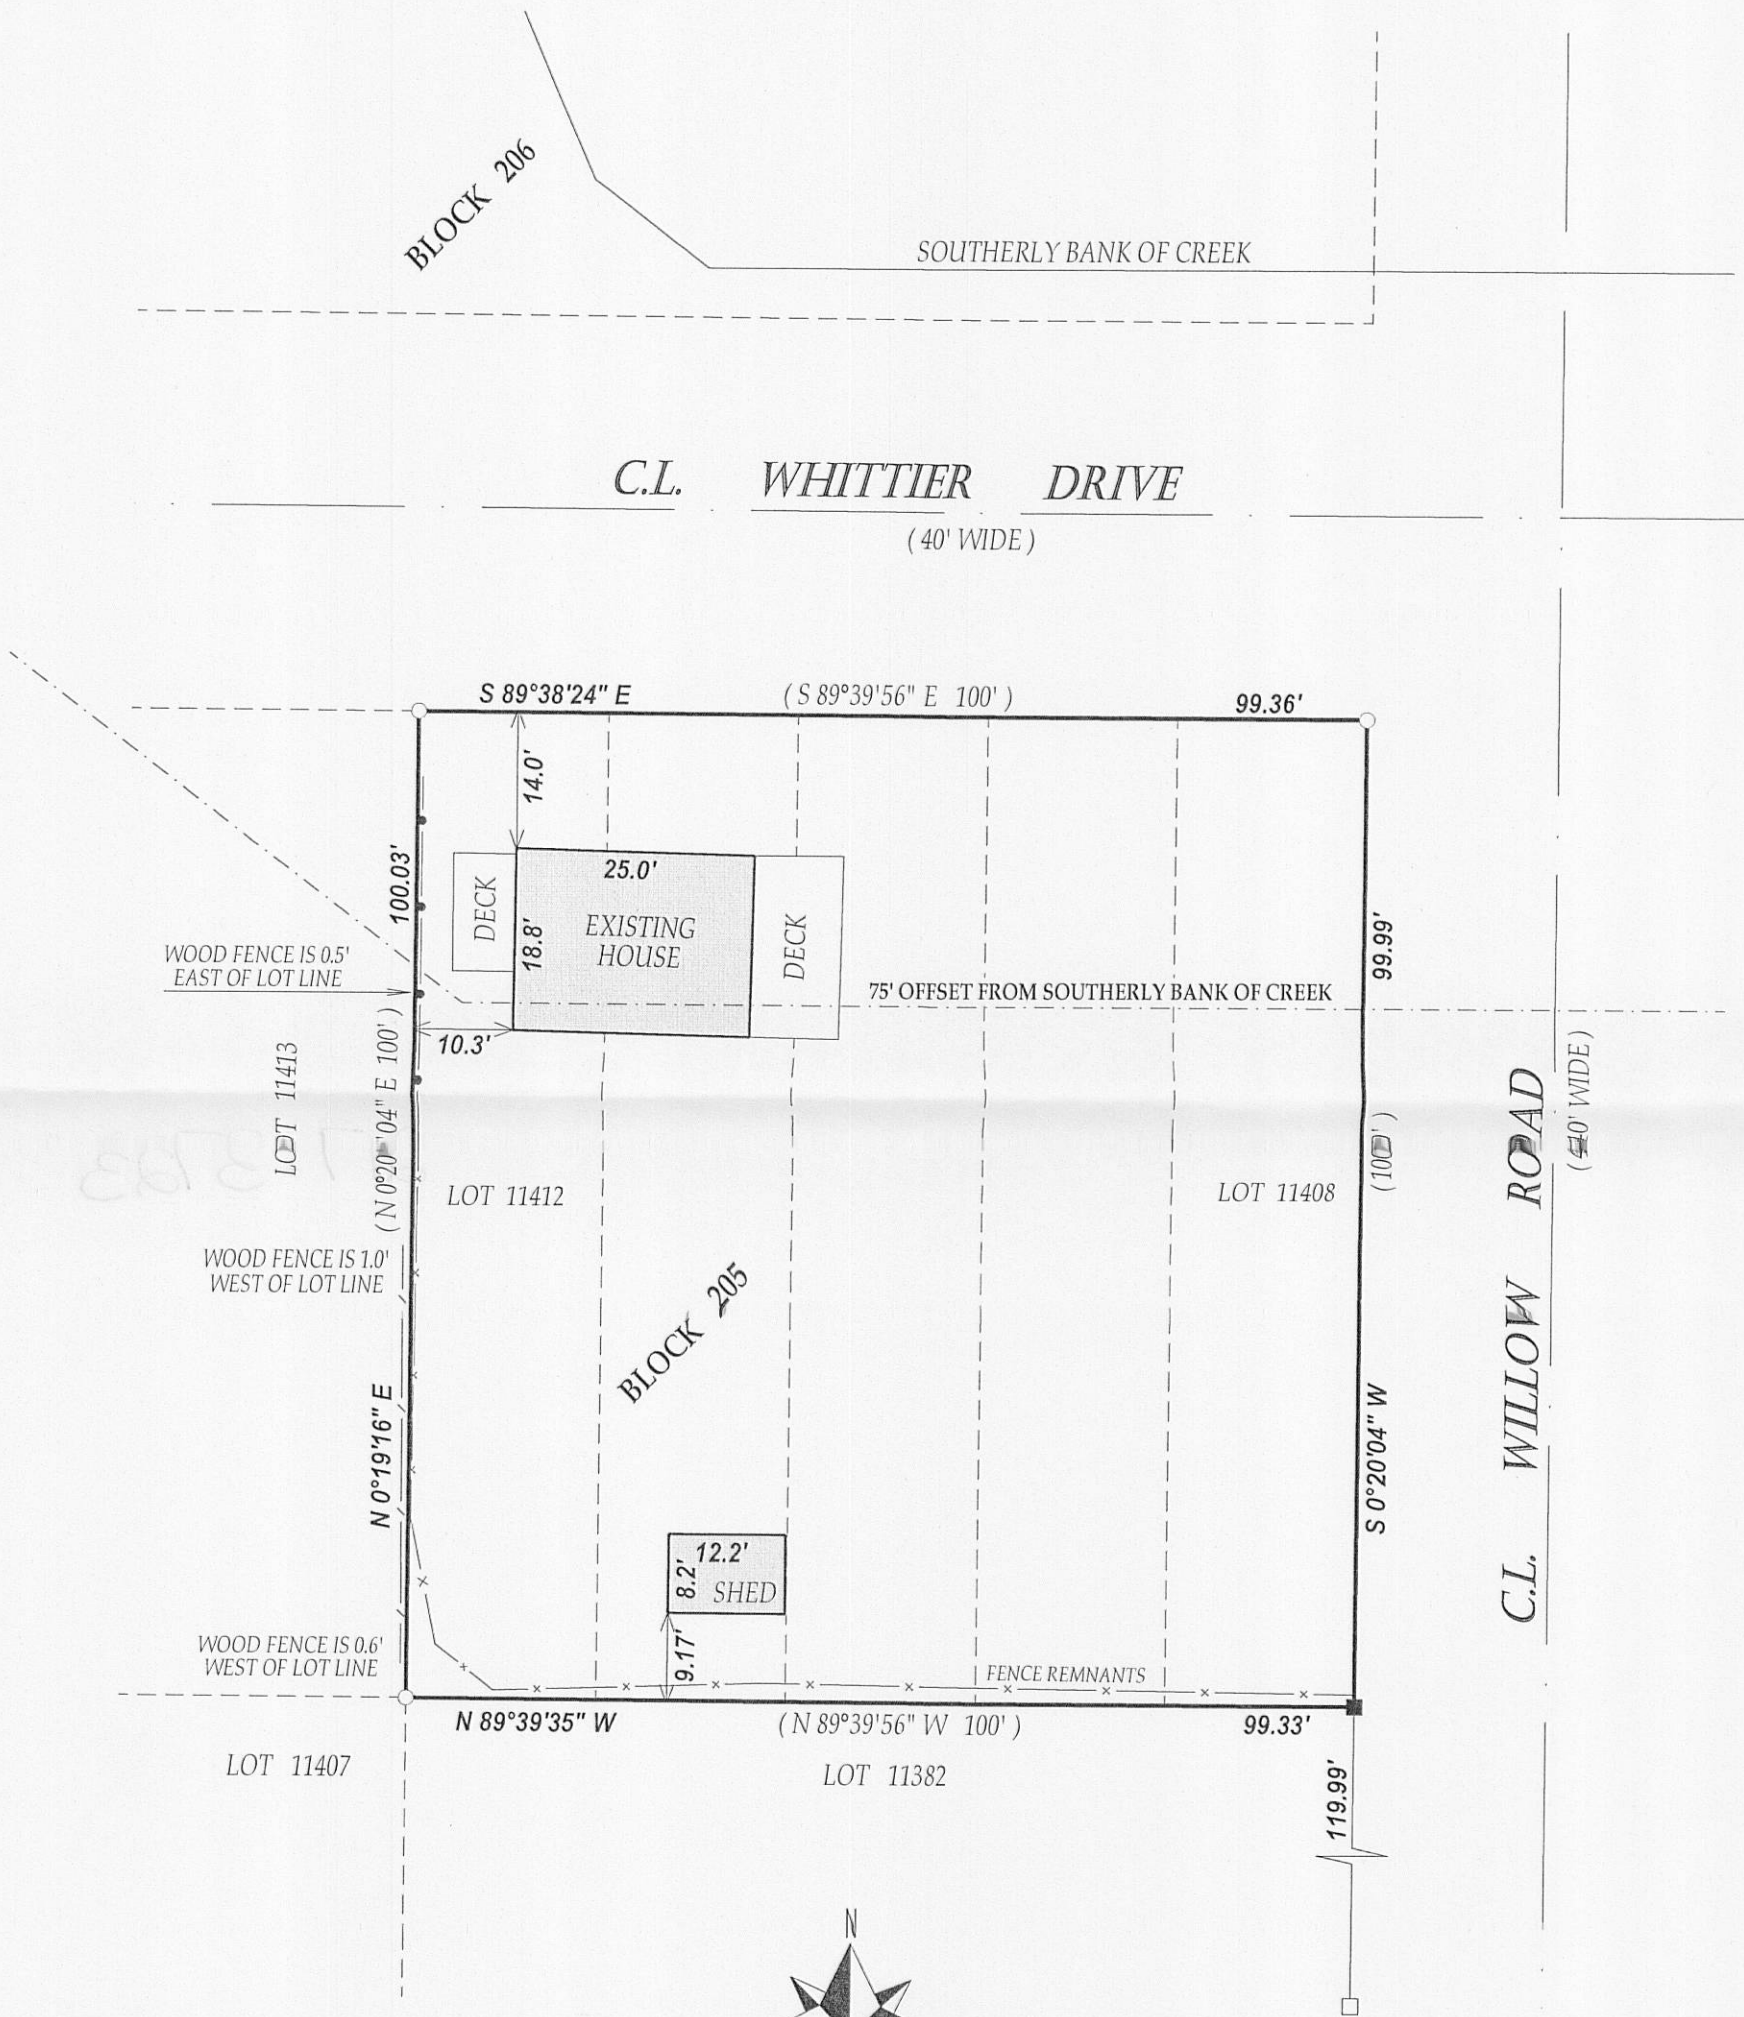

LEGEND


- FOUND IRON PIPE
- FOUND IRON BAR
- SET IRON BAR

(xx) RECORDED AS  
TAX ID # JLCB02481  
JOB # 11-099

NOTE: BEARINGS ARE REFERENCED TO THE RECORD PLAT OF LAKE COMO BEACH SUB.

I have surveyed the above-described property and the above map is a true representation thereof and shows the size and location of the property, its exterior boundaries, the location and dimensions of all structures thereon, fences apparent easements and roadways and visible encroachments, if any.

This survey is made for the exclusive use of the present owners of the property, and also those who purchase, mortgage, or insure the title thereto within one (1) year from date hereof; and as to them I warrant the accuracy of said survey map.

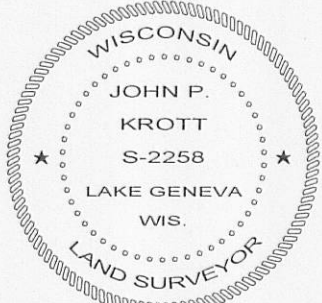

DATED THIS 28th DAY OF JUNE 2011.

JOHN KROTT S - 2258  
Wisconsin Registered Land Surveyor  
(original if signed in red)

217-3723 82183