


PREPARED FOR  
MARGARET LABUS  
KEEFE REAL ESTATE  
751 GENEVA PARKWAY  
LAKE GENEVA WI 53147

KROTT SURVEYING INC.  
N3705 WILLOW BEND LANE  
LAKE GENEVA WI. 53147  
PHONE # (262)248-3697  
FAX # (262)249-0639

C.L. FOREST ROAD  
(40' WIDE)

C.L. ELM ROAD  
(40' WIDE)

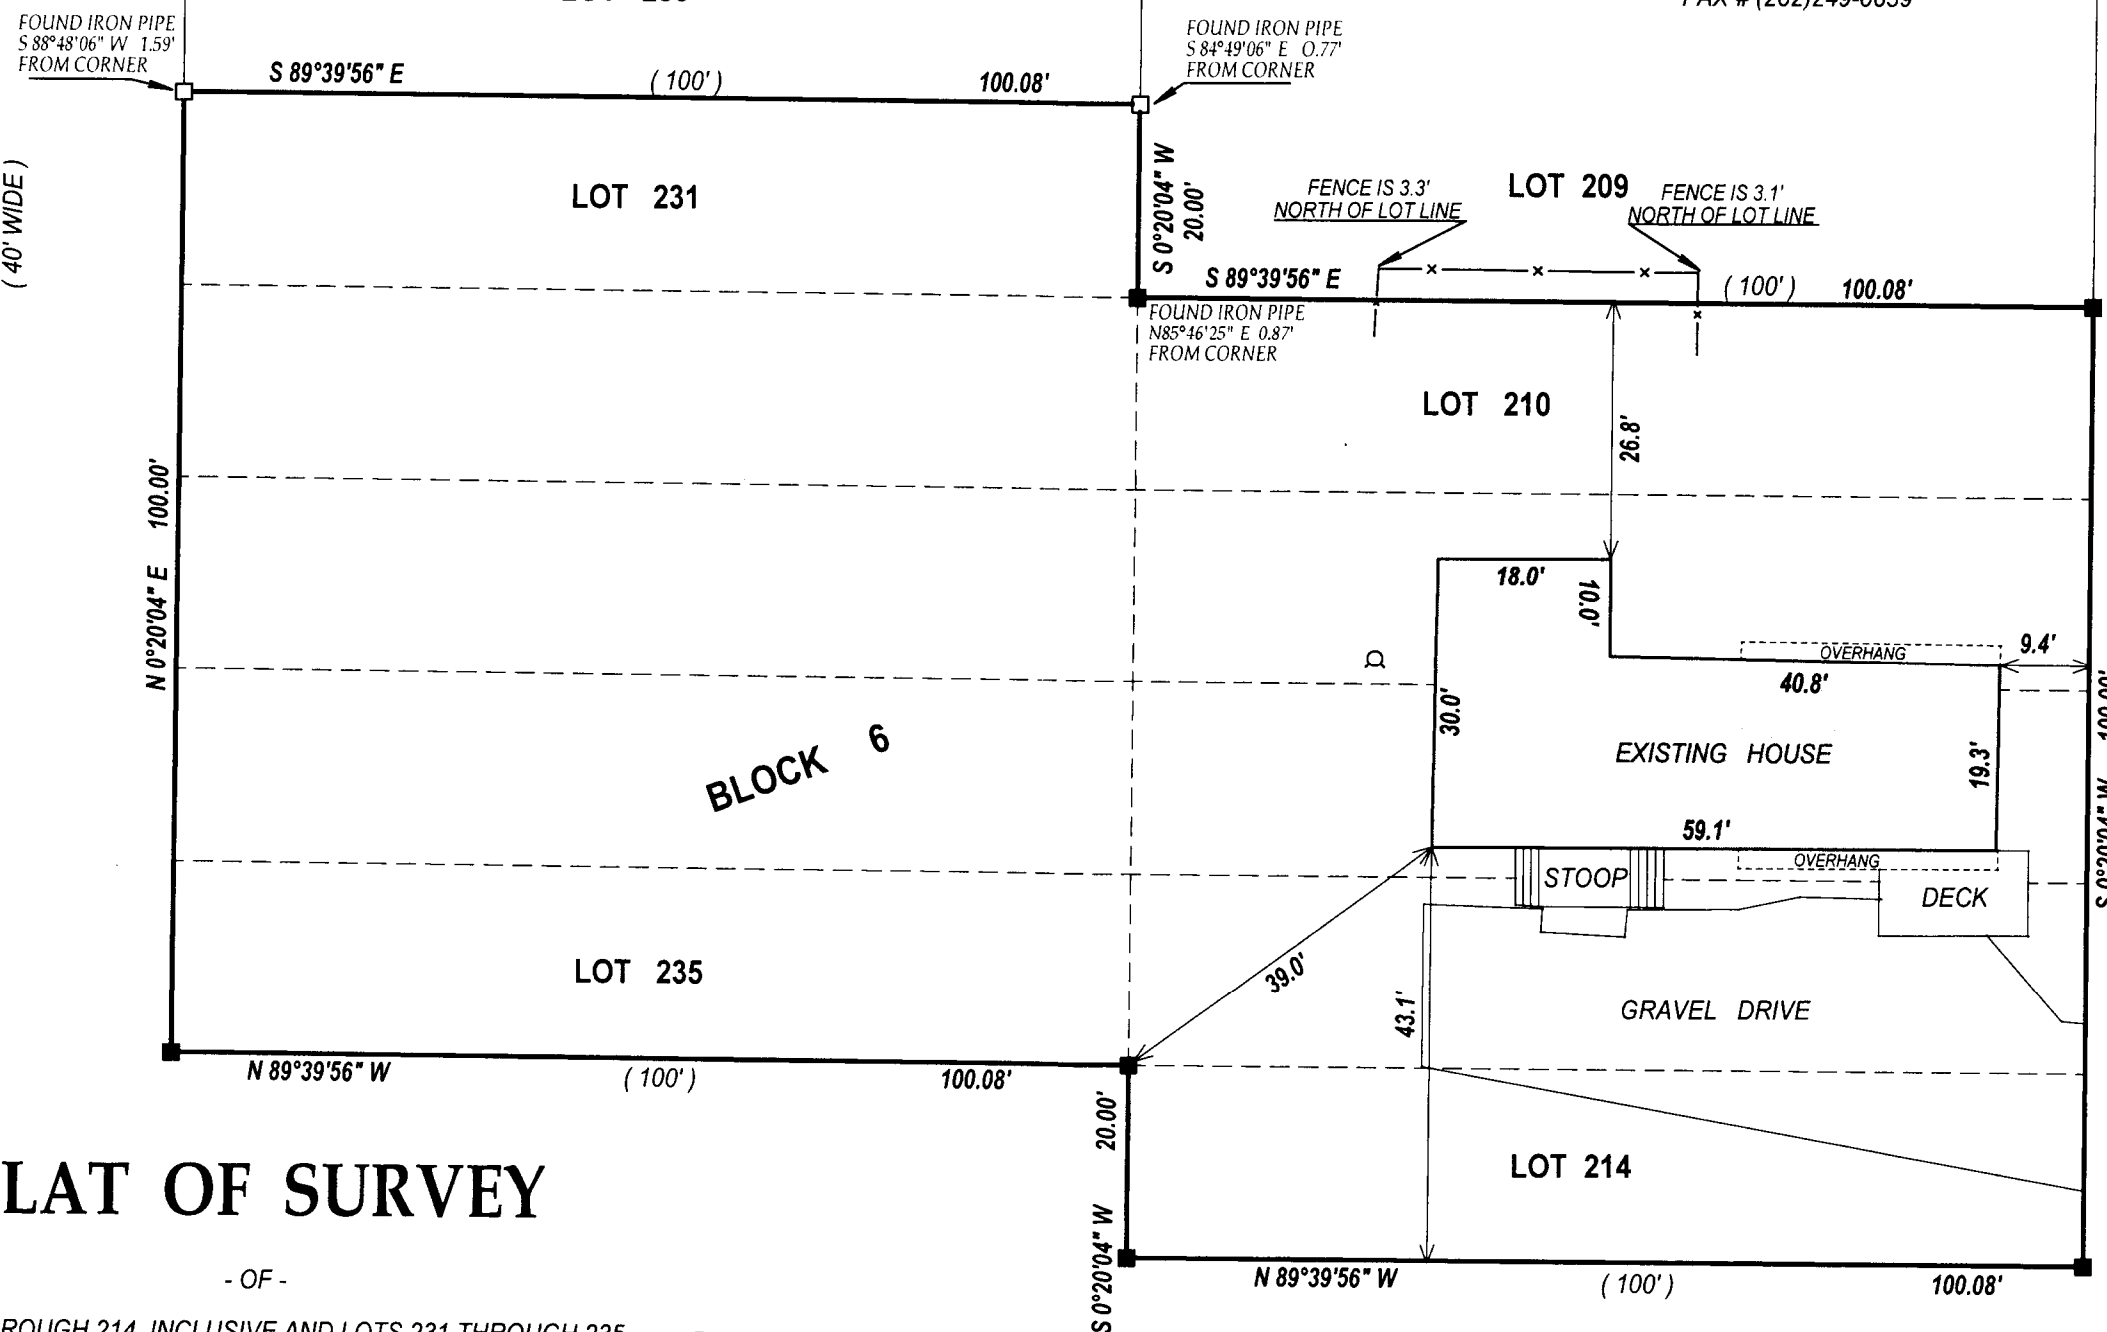

# PLAT OF SURVEY

- OF -


COUNTY TRUNK HIGHWAY "H"  
WIDTH VARIES

LOTS 210 THROUGH 214, INCLUSIVE AND LOTS 231 THROUGH 235, INCLUSIVE, BLOCK 6, OF LAKE COMO BEACH SUBDIVISION 3rd MAP, ACCORDING TO THE RECORD PLAT THEREOF, TOWN OF GENEVA WALWORTH COUNTY, WISCONSIN.

I have surveyed the above-described property and the above map is a true representation thereof and shows the size and location of the property, its exterior boundaries, the location and dimensions of all structures thereon, fences apparent easements and roadways and visible encroachments, if any.



This survey is made for the exclusive use of the present owners of the property, and also those who purchase, mortgage, or insure the title thereto within one (1) year from date hereof, and as to them I warrant the accuracy of said survey map.

NOTE: BEARINGS ARE REFERENCED TO THE RECORD PLAT

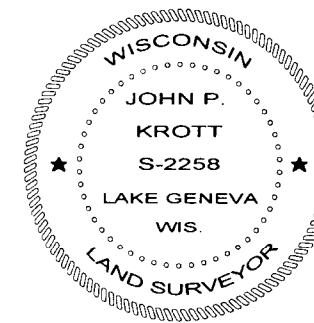

DATED THIS 17th DAY OF SEPTEMBER 2011.

JOHN KROTT S - 2258  
Wisconsin Registered Land Surveyor  
(original if signed in red)

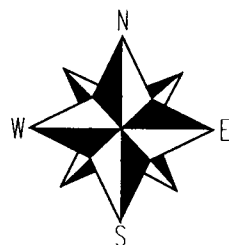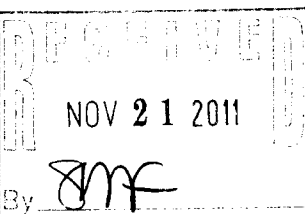

SCALE 1" = 20'

## LEGEND

- FOUND IRON PIPE
- FOUND IRON BAR
- SET IRON BAR
- WELL

(XX) RECORDED AS  
TAX ID # JLCB00029B & 31B  
JOB # 11-162

217-3748