

PREPARED FOR:  
KYLE BIRD  
N3882 BIRD PLACE  
LAKE GENEVA, WI 53147

PLAT OF SURVEY



KROTT SURVEYING, INC.  
N3705 WILLOW BEND LANE  
LAKE GENEVA, WI 53147  
(262)- 248-3697

- OF -

LOTS 9344-9350 BLOCK 168 OF LAKE COMO BEACH SUBDIVISION;  
LOCATED IN TOWN 2 NORTH, RANGE 17 EAST, WALWORTH COUNTY,  
WISCONSIN

C.L. BIRD PLACE

( 40' WIDE ROAD )

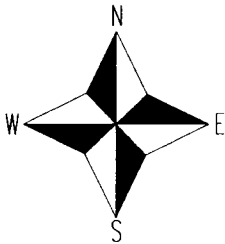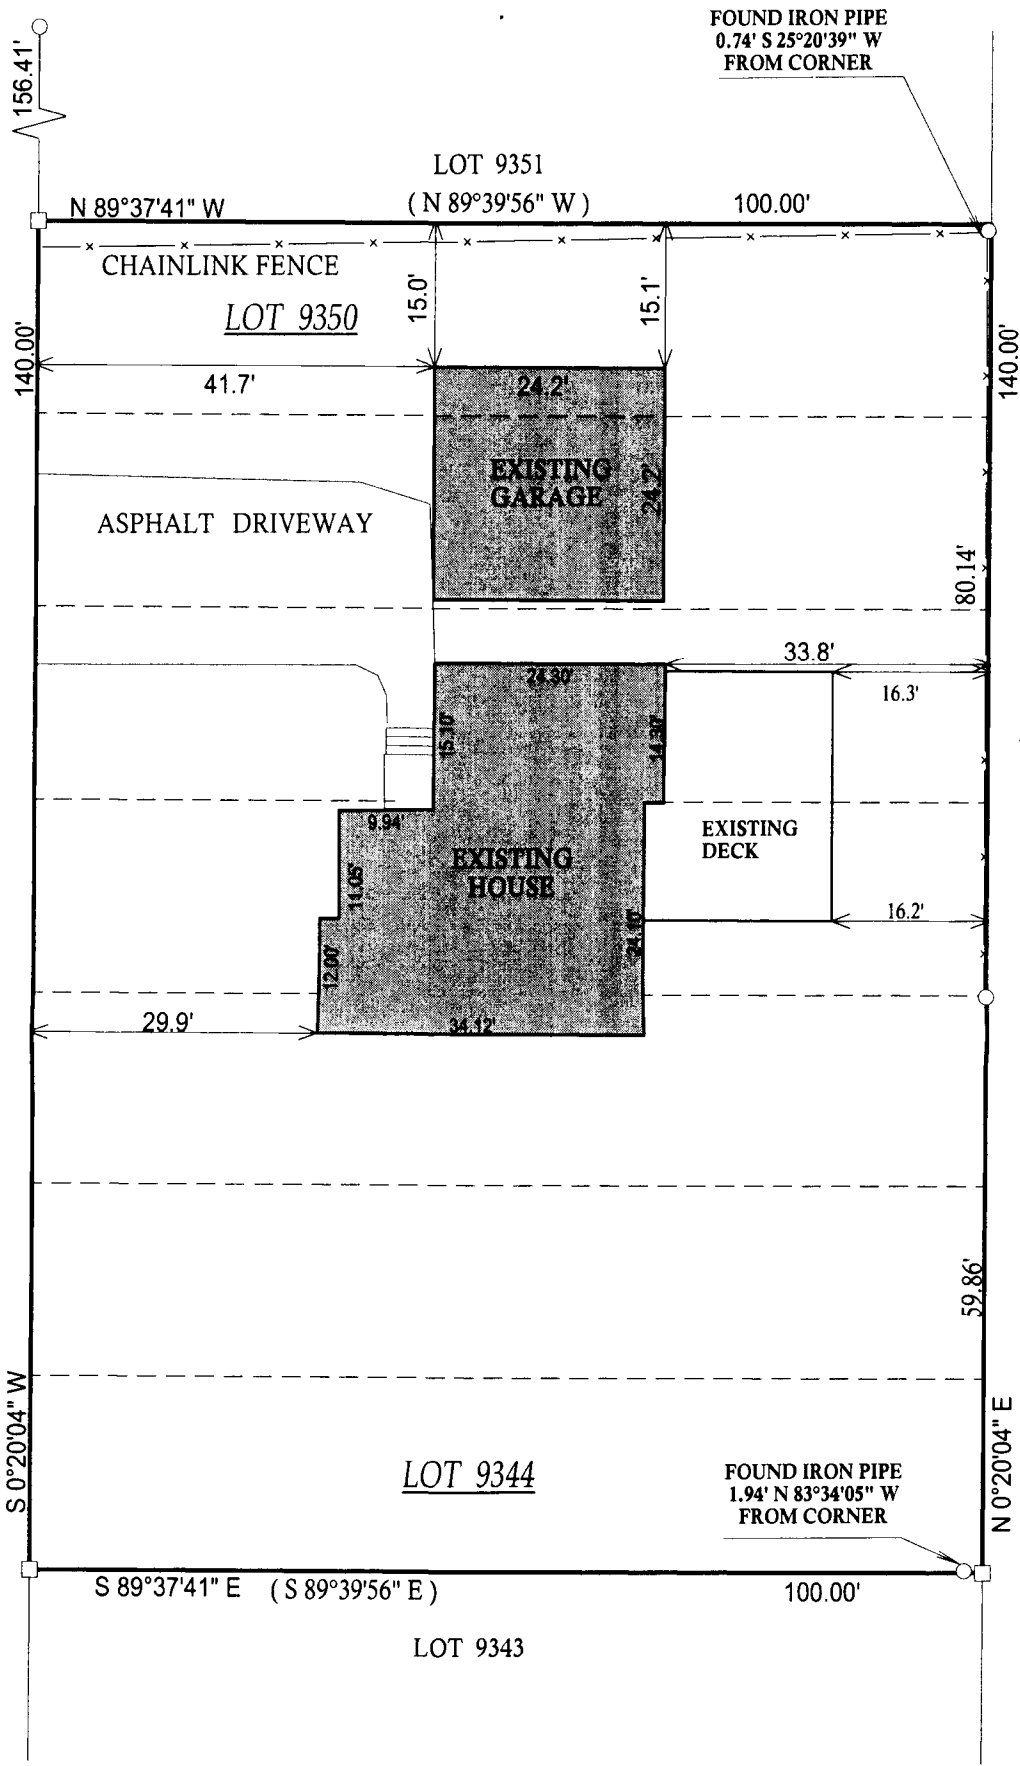

- ( ) = recorded as
- = found iron bar
  - = found iron pipe
  - = set iron pipe
  - = set iron bar

SCALE 1" = 20'

JOB # 02-545PG

TAX ID # JLCB02014



BEARINGS REFERENCED TO THE RECORD  
PLAT OF LAKE COMO BEACH

I have surveyed the above-described property and the above map is a true representation thereof and shows the size and location of the property, its exterior boundaries, the location and dimensions of all structures thereon, fences apparent easements and roadways and visible encroachments, if any.

This survey is made for the exclusive use of the present owners of the property, and also those who purchase, mortgage, or insure the title thereto within one (1) year from date hereof; and as to them I warrant the accuracy of said survey map.



DATE OF LAST REVISION: 11 / 10 / 2011  
DATED THIS 17th, DAY OF NOVEMBER, 2010

*John P. Krott*

JOHN KROTT S - 2258  
Wisconsin Registered Land Surveyor  
( original if signed in red )

217-3752