

PREPARED FOR  
DIANE COCROFT  
KEEFE REAL ESTATE  
751 GENEVA PARKWAY  
LAKE GENEVA WI. 53147


# PLAT OF SURVEY

-OF-

LOTS 1081 THROUGH 1084, INCLUSIVE AND LOTS 1110 THROUGH 1113,  
INCLUSIVE, ALL IN BLOCK 18, IN THE THIRD MAP OF LAKE COMO BEACH  
BEING LOCATED IN THE TOWN OF GENEVA, COUNTY OF WALWORTH  
AND STATE OF WISCONSIN.

KROTT SURVEYING INC.

N3705 WILLOW BEND LANE  
LAKE GENEVA WI. 53147  
PHONE # (262)248-3697  
FAX # (262)249-0639

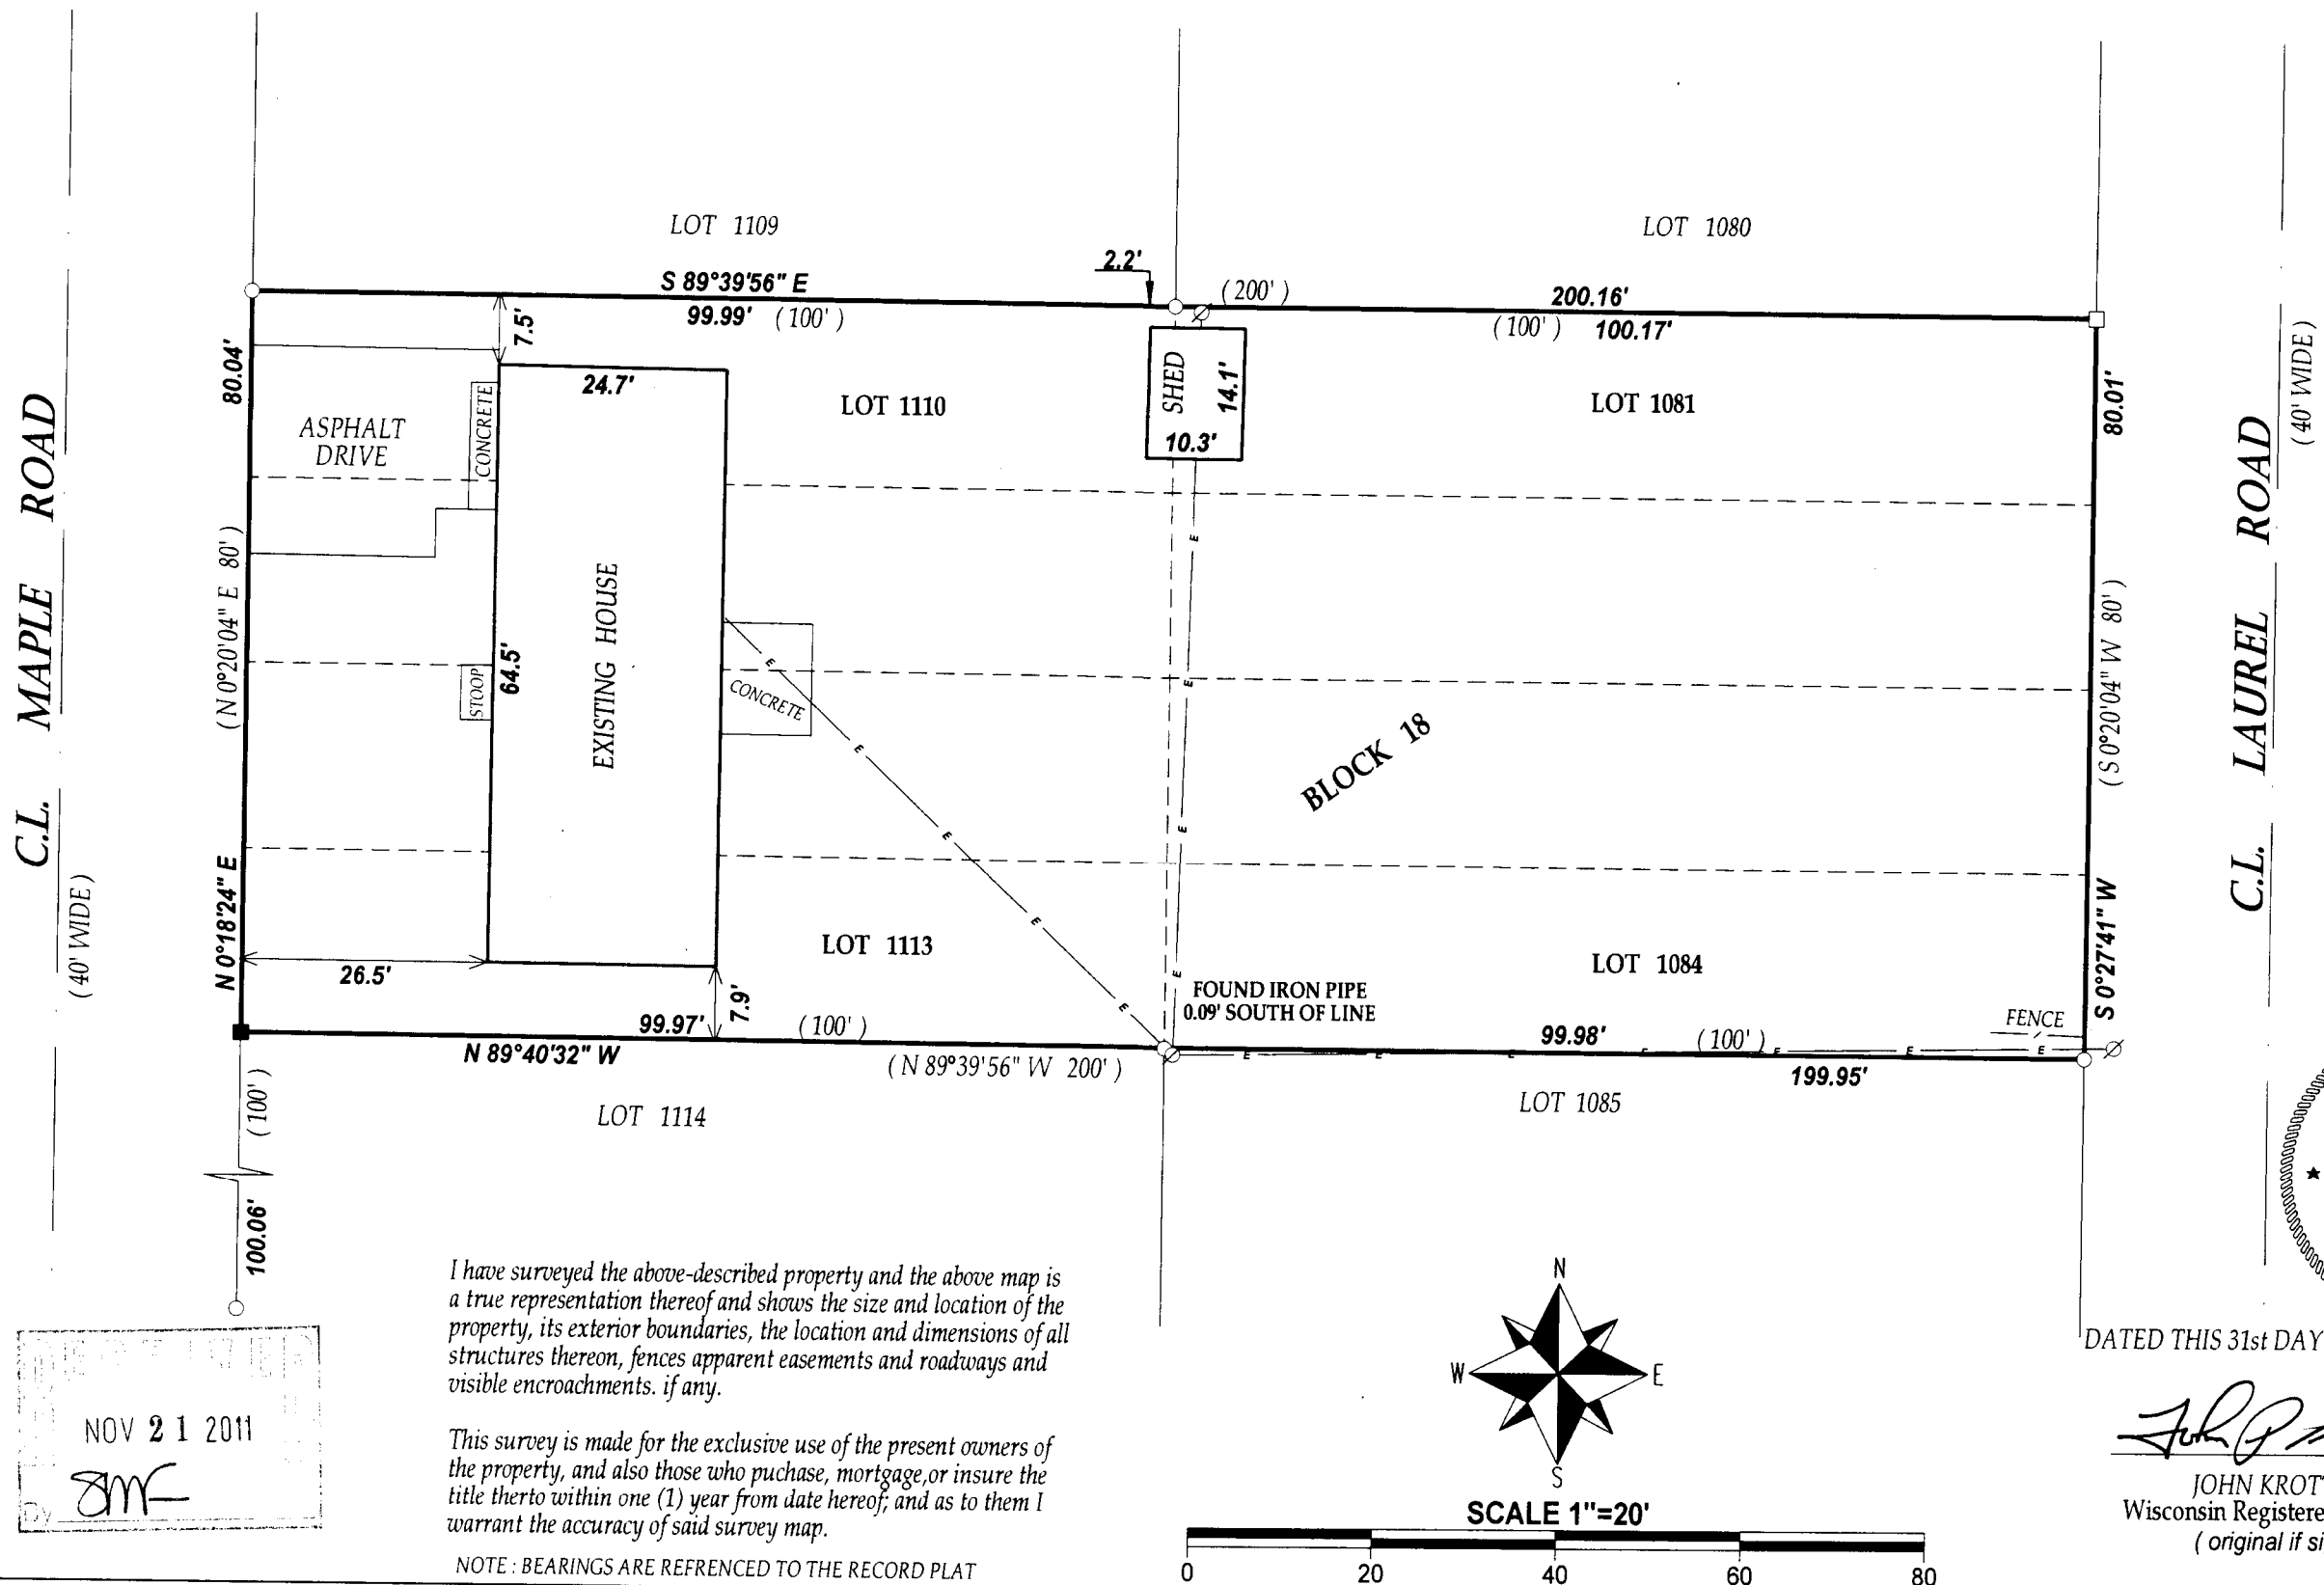

217-3753