PREPARED FOR DANA MONTANA 5065 HIGHWAY "50" DELAVAN WI 53115


PLAT OF SURVEY


-OF-

00/112

LOTS 1649 THRU 1660 AND LOTS 1665 THRU 1676 BLOCK 27, LAKE COMO BEACH SUBDIVISION, TOWN 2 NORTH, RANGE 17 EAST, WALWORTH COUNTY, WISCONSIN. KROTT SURVEYING INC.

N3705 WILLOW BEND LANE LAKE GENEVA WI. 53147 PHONE # (262)248-3697 FAX # (262)249-0639

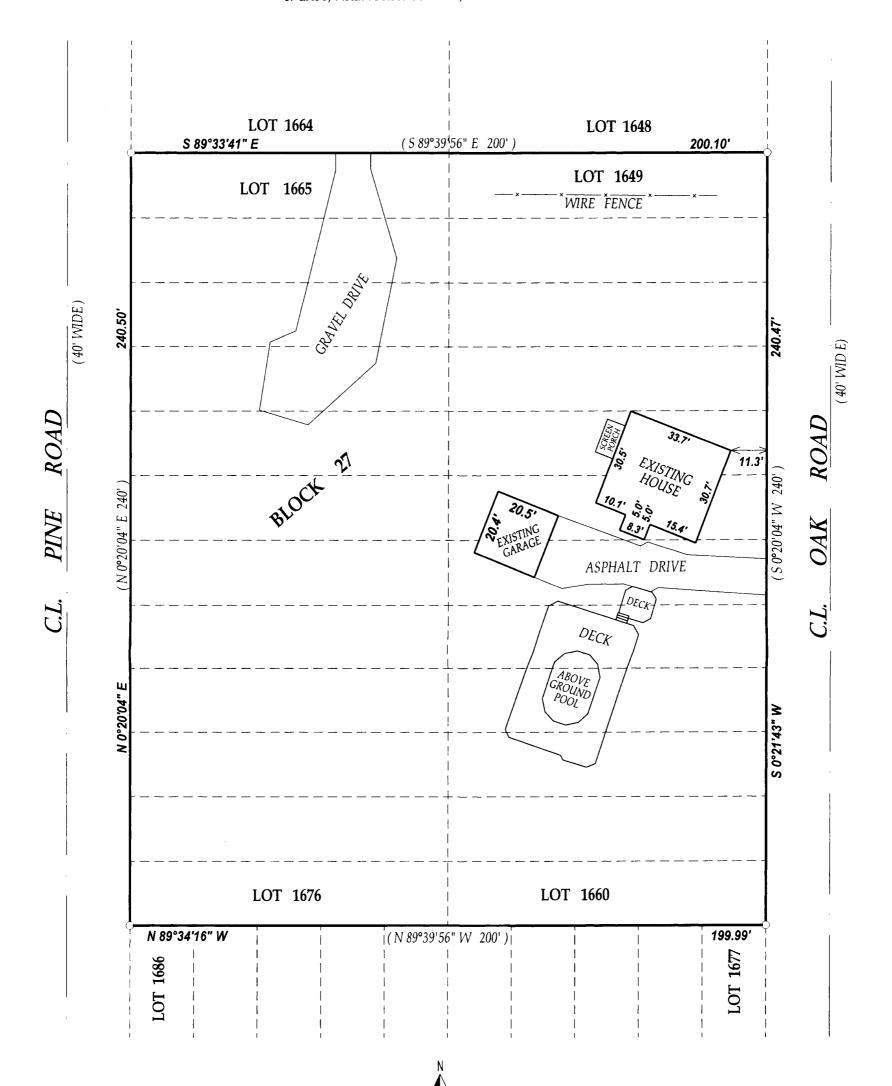

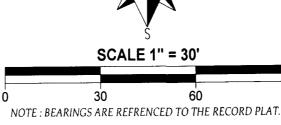

I have surveyed the above-described property and the above map is a true representation thereof and shows the size and location of the property, its exterior boundaries, the location and dimensions of all structures thereon, fences apparent easements and roadways and visible encroachments. if any.

This survey is made for the exclusive use of the present owners of the property, and also those who puchase, mortgage, or insure the title therto within one (1) year from date hereof; and as to them I warrant the accuracy of said survey map.



DATED THIS 17th DAY OF OCTOBER 2011.

JOHN KROTT S - 2258 Wisconsin Registered Land Surveyor

(original if signed in red)

(XX) RECORDED AS

TAX ID # JLCB00258

JOB # 11-152

LEGEND

O FOUND IRON PIPE

