PREPARED FOR: LAKE GENEVA AREA REALTY 101 BROAD ST LAKE GENEVA, WI.

## PLAT OF SURVEY

- OF -


LOTS 6304 THROUGH 6308, INCLUSIVE, BLOCK 109, LAKE COMO BEACH SUBDIVISION, TOWN OF GENEVA, WALWORT COUNTY, WISCONSIN.


PATHFINDER SURVEYING INC.
(formerly)

J.K. SURVEYING INC.
P.O BOX 322

LAKE GENEVA, WI. 53147

WWW.PATHFINDERSURVEYING.NET
262-248-8303

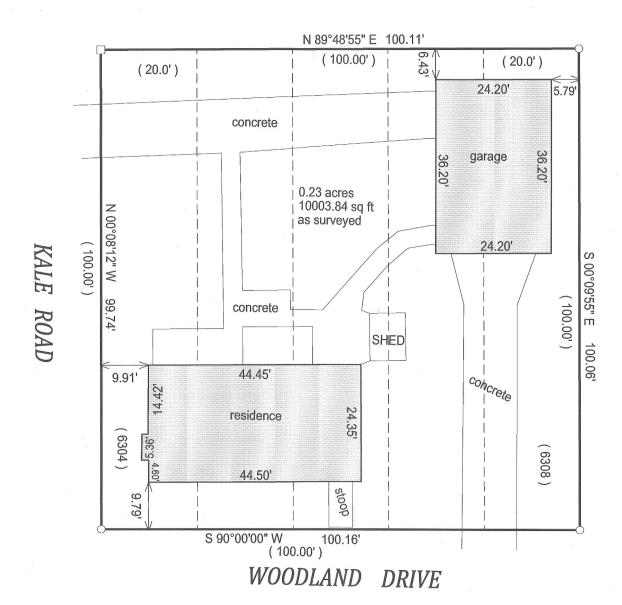


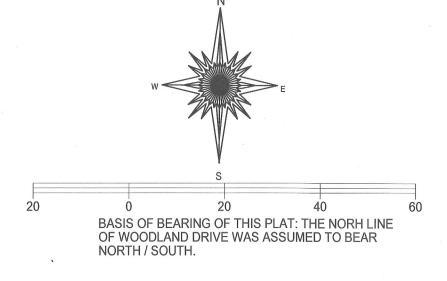

"I hereby certify that I have surveyed the above described property and that the above map is a true representation of its exterior boundary and shows the size and location of all visible structures, apparent easements and encroachments if any."

This survey is made for the present owners of the property, and those who purchase, mortgage, or guarantee the title thereto, within one year from the date hereof.

DATED THIS 11TH DAY OF NOVEMBER, 2011.

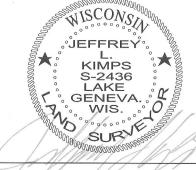

JEFFREY L KIMPS S - 2436 Wisconsin Registered Land Surveyor ( original if signed in red )

TAX ID # JLCB 01307

( )= recorded as

☐ = found iron bar

= found iron pipe

= set iron pipe

= set iron bar

SCALE 1" = 20'

JOB # 11-155

217-3779