




PREPARED FOR  
FRANCOIS ZAKHEM  
W3759 S DEER DR  
LAKE GENEVA, WI 53147

PLAT OF SURVEY

- OF -

PATHFINDER SURVEYING INC.  
(formerly)  
J.K. SURVEYING INC.  
P.O BOX 322  
LAKE GENEVA, WI. 53147  
WWW.PATHFINDERSURVEYING.NET  
262-248-8303

LOT 9 DEER CROSSING, A RESUBDIVISION OF LOT 2 OF CERTIFIED SURVEY MAP No. 2932,  
LOCATED IN THE NE 1/4 OF THE SE 1/4 OF SECTION 21, TOWN 2 NORTH, RANGE 17 EAST,  
TOWN OF GENEVA, WALWORTH COUNTY, WISCONSIN.

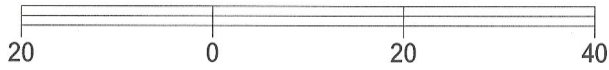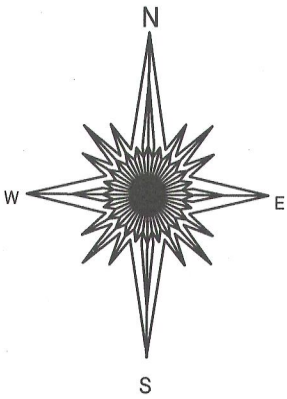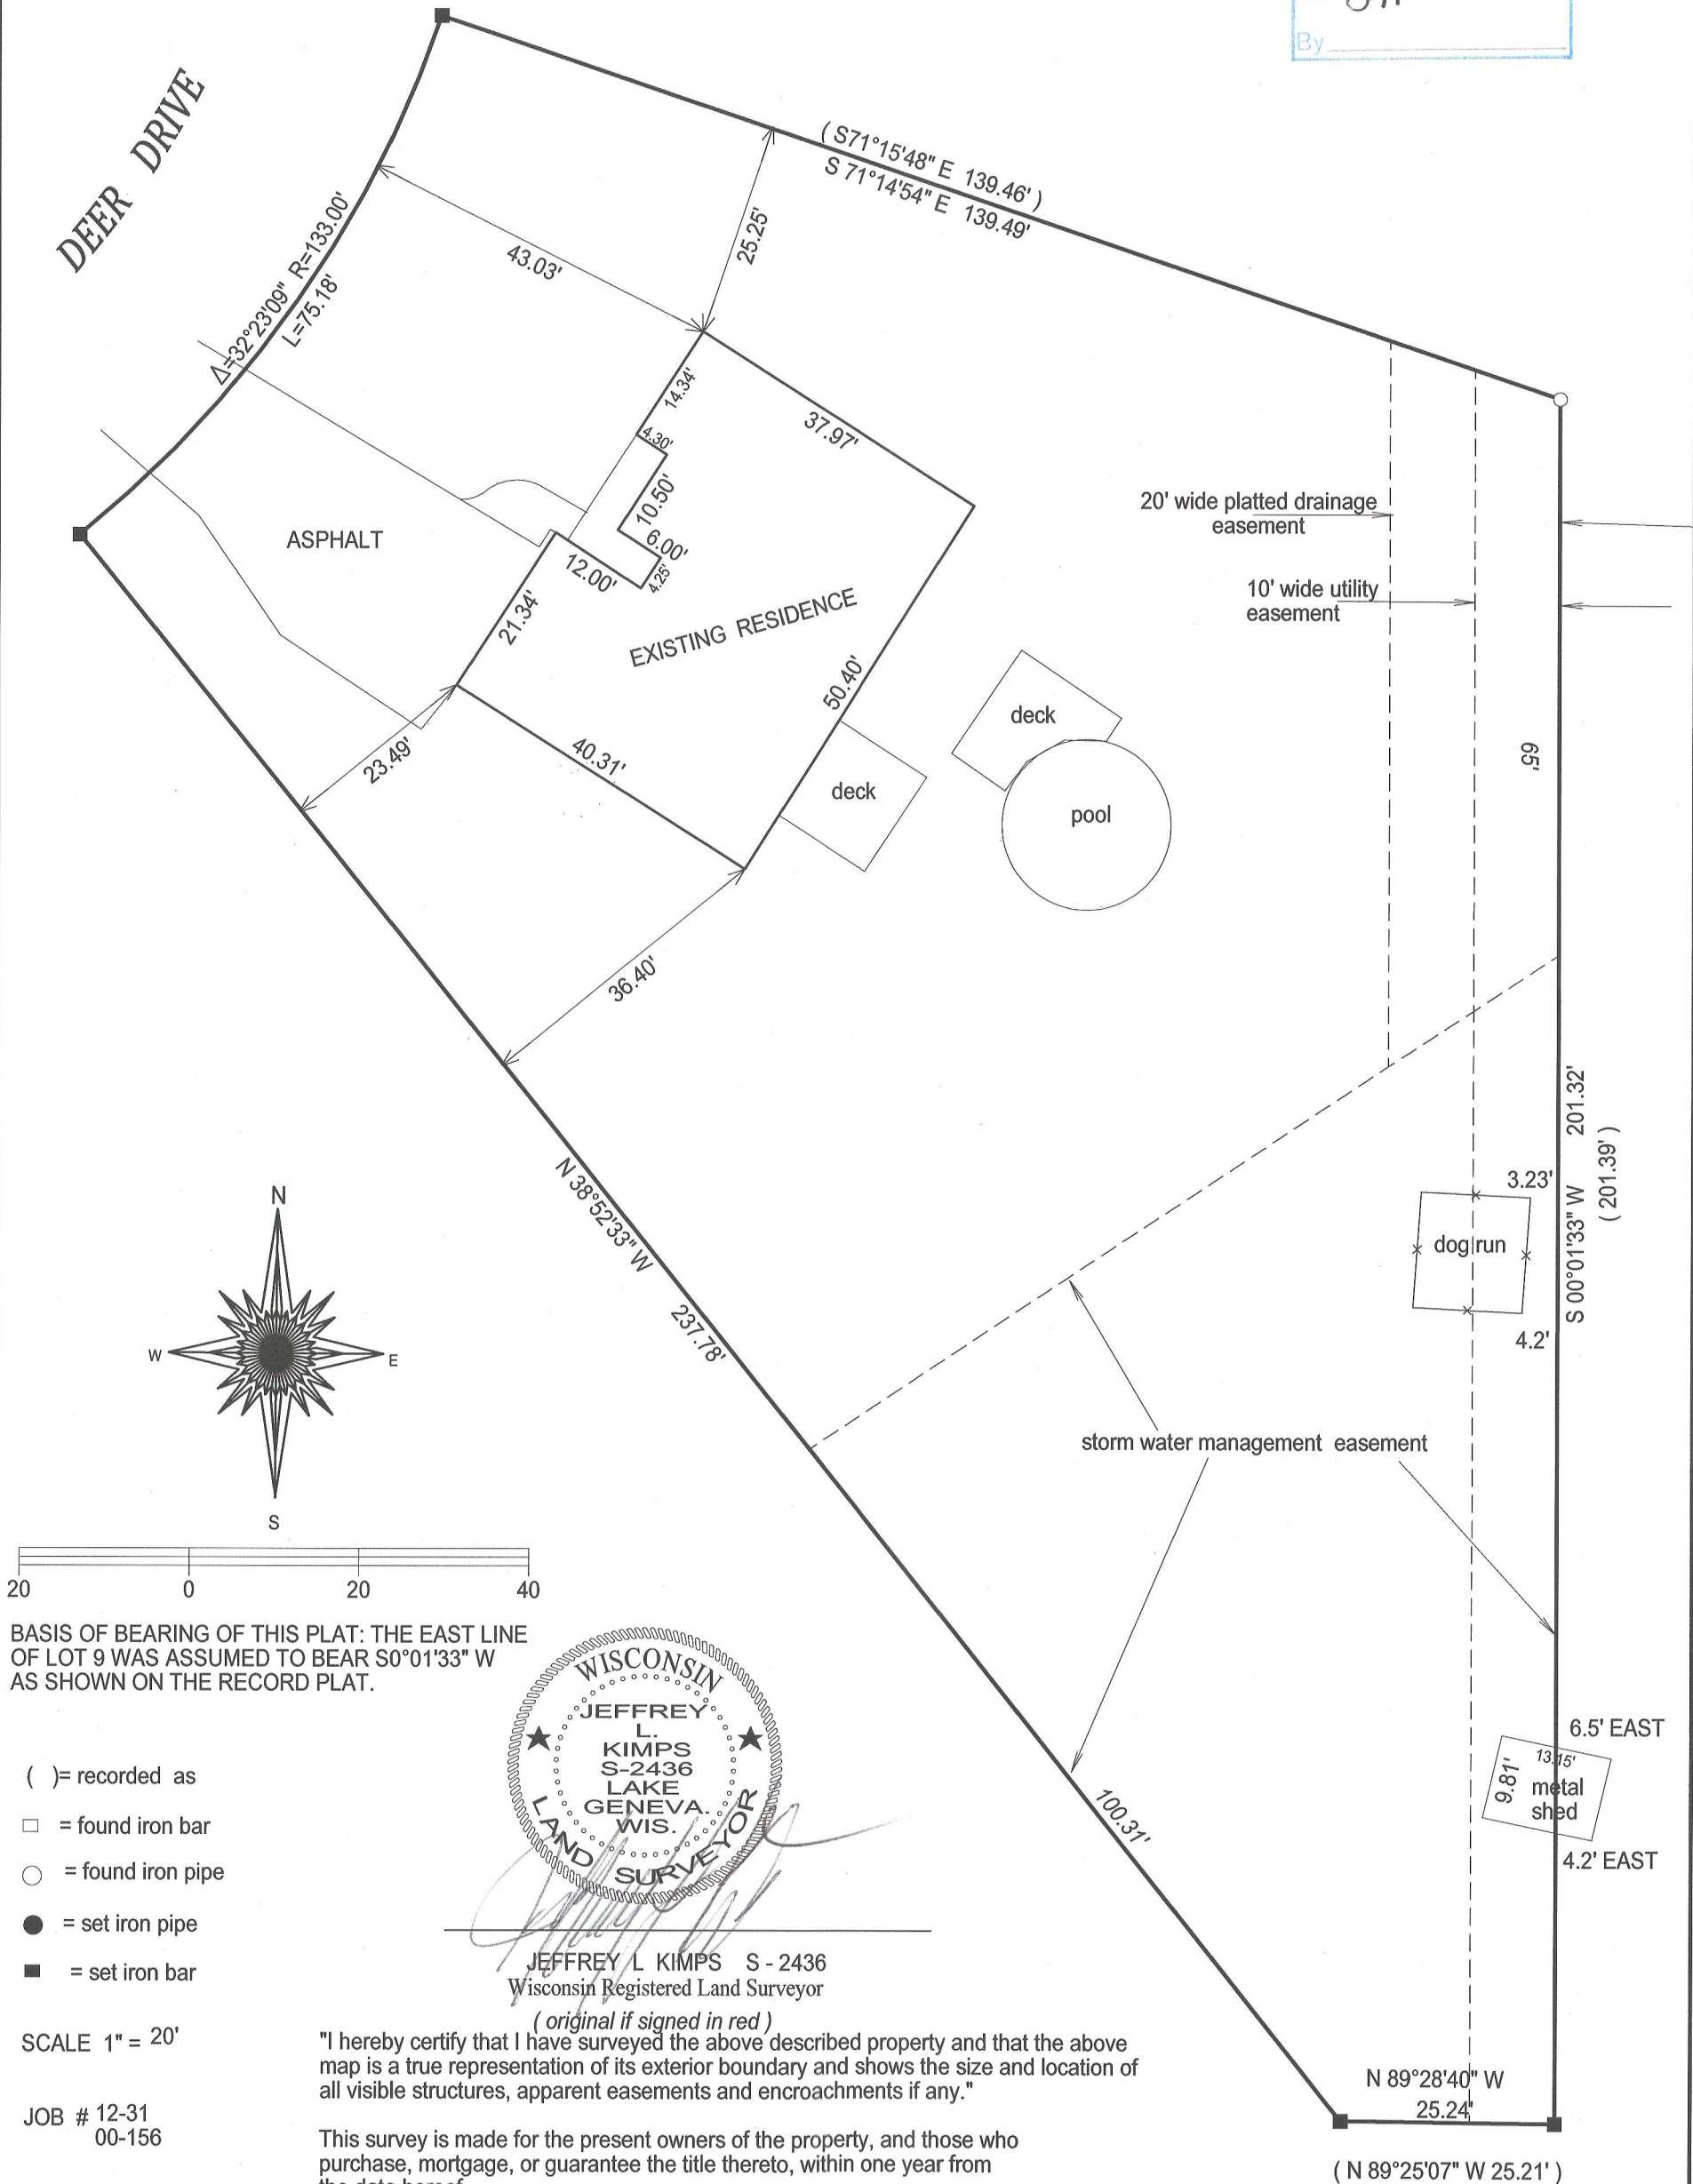


BASIS OF BEARING OF THIS PLAT: THE EAST LINE  
OF LOT 9 WAS ASSUMED TO BEAR S0°01'33" W  
AS SHOWN ON THE RECORD PLAT.

- ( ) = recorded as
- = found iron bar
- = found iron pipe
- = set iron pipe
- = set iron bar

SCALE 1" = 20'

JOB # 12-31  
00-156

TAX ID #  
JDE 00009

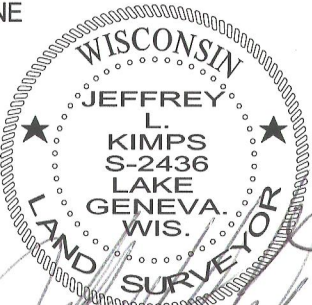

JEFFREY L. KIMPS S - 2436  
Wisconsin Registered Land Surveyor

(original if signed in red)

"I hereby certify that I have surveyed the above described property and that the above  
map is a true representation of its exterior boundary and shows the size and location of  
all visible structures, apparent easements and encroachments if any."

This survey is made for the present owners of the property, and those who  
purchase, mortgage, or guarantee the title thereto, within one year from  
the date hereof.

DATED THIS 3RD DAY OF APRIL, 2012.

217-3780