



UNIT 16-17

GOLF CLUB GROUNDS

BM: TOP REBAR
ELEV: 1034.90

WORK ORDERED BY:
CHRIS CHABRAJA
70 WEST MADISON STREET, SUITE 2600
CHICAGO, IL. 60602

LEGAL DESCRIPTION OF LAND SURVEYED:
UNIT 16-16 OF GENEVA NATIONAL CONDOMINIUM NO. 16 IN THE TOWN OF GENEVA, WALWORTH COUNTY, WISCONSIN ACCORDING TO THE CONDOMINIUM PLAT THEREOF RECORDED.


NOTE: COPIES OF THIS MAP TO WHICH THE FOLLOWING CERTIFICATE WILL APPLY SHOW SURVEYOR'S ORIGINAL SEAL AND SIGNATURE IN RED INK. COPIES BY ANY OTHER MEANS MAY HAVE ALTERATIONS WHICH DO NOT REPRESENT THE SURVEYOR'S WORK PRODUCT.

I HEREBY CERTIFY THAT THE ABOVE DESCRIBED PROPERTY HAS BEEN SURVEYED UNDER MY DIRECTION AND THAT THE ABOVE MAP IS A TRUE REPRESENTATION THEREOF AND SHOWS THE SIZE AND LOCATION OF THE PROPERTY, ITS EXTERIOR BOUNDARIES, THE LOCATION OF ALL VISIBLE STRUCTURES, AND DIMENSIONS OF ALL PRINCIPLE BUILDINGS THEREON, BOUNDARY FENCES, APPARENT BASEMENTS, ROADWAYS, AND VISIBLE ENCROACHMENTS, IF ANY. THIS SURVEY IS MADE FOR THE USE OF THE PRESENT OWNERS OF THE PROPERTY, AND ALSO THOSE WHO PURCHASE, MORTGAGE, OR GUARANTEE THE TITLE THERETO WITHIN ONE YEAR FROM THE DATE HEREOF.

DATED: OCT. 22, 2002
Peter S. Gordon
PETER S. GORDON R.L.S. 2101

Resurveyed 11/5/2013

NOV 27 2013
jlc

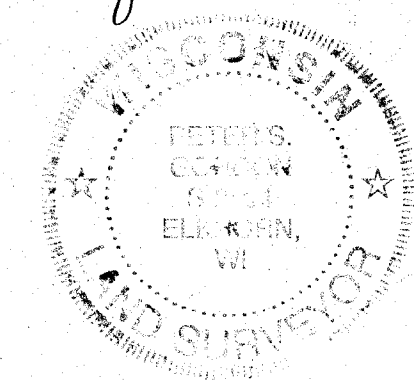

UNIT 16-15

FAIRWAY CT.
(66' WIDE PRIVATE ROADWAY)

RYDER CUP ROAD
(66' WIDE PRIVATE ROADWAY)


UNIT 16-16
20,233 SQ. FT.

AS BUILT
RESIDENCE

PAVED DRIVE

MAP LEGEND

- = 1/2" IRON REBAR STAKE FOUND
- = 1/2"x18" IRON REBAR STAKE SET
- ▲ = FIRE HYDRANT
- ⊙ = WATER SERVICE VALVE
- ⊗ = SANITARY SEWER MANHOLE
- ⊠ = WATER MAIN VALVE
- = WOOD STAKE SET
- ▣ = TELEVISION UTILITY BOX
- ▤ = ELECTRIC UTILITY BOX
- ▥ = TELEPHONE UTILITY BOX
- ⊞ = ELECTRIC TRANSFORMER
- = CONTOURS FROM PHOTOGRAMMETRIC MAPPING BY SIDWELL APRIL 1989

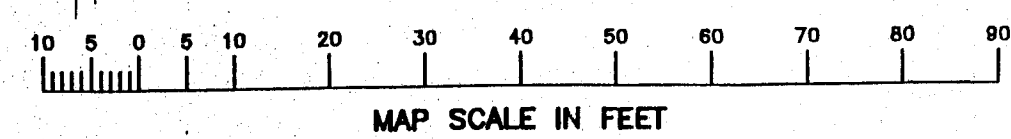


REVISIONS

FARRIS, HANSEN & ASSOCIATES, INC.
Engineering, Architecture, Surveying
7 Ridgway Court P.O. Box 437
ELKHORN, WISCONSIN 53121
Office: (414) 723-2098
Fax: (414) 723-5886

PLAT OF SURVEY

GENEVA NATIONAL
UNIT 16-16
1620 Ryder Cup Road
Town of Geneva, Walworth Co., Wisconsin

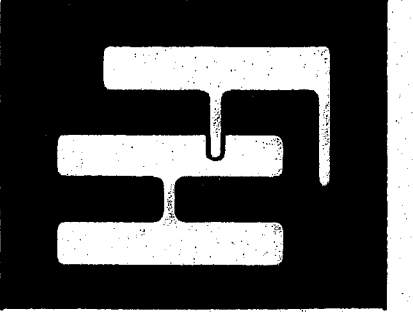

NOV 05 2013
16-16