





PREPARED FOR
MIKE KUEHN

PLAT OF SURVEY

PATHFINDER SURVEYING INC.
(formerly)
J.K. SURVEYING INC.
P.O BOX 322
LAKE GENEVA, WI. 53147
WWW.PATHFINDERSURVEYING.NET
262-248-8303

- OF -

LOTS 15 AND 16 BLOCK 25 SUNSET HILLS, A SUBDIVISION OF PART
OF SECTION 33, TOWN 2 NORTH, RANGE 17 EAST, TOWN OF GENEVA,
COUNTY OF WALWORTH AND STATE OF WISCONSIN.

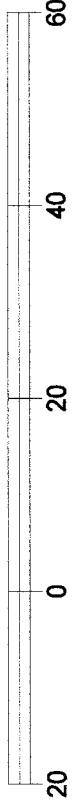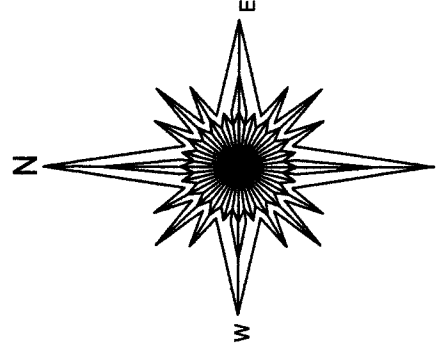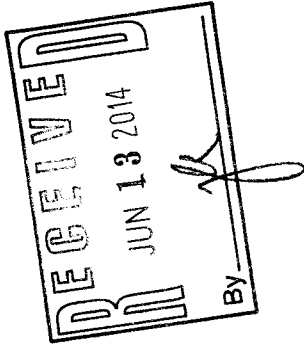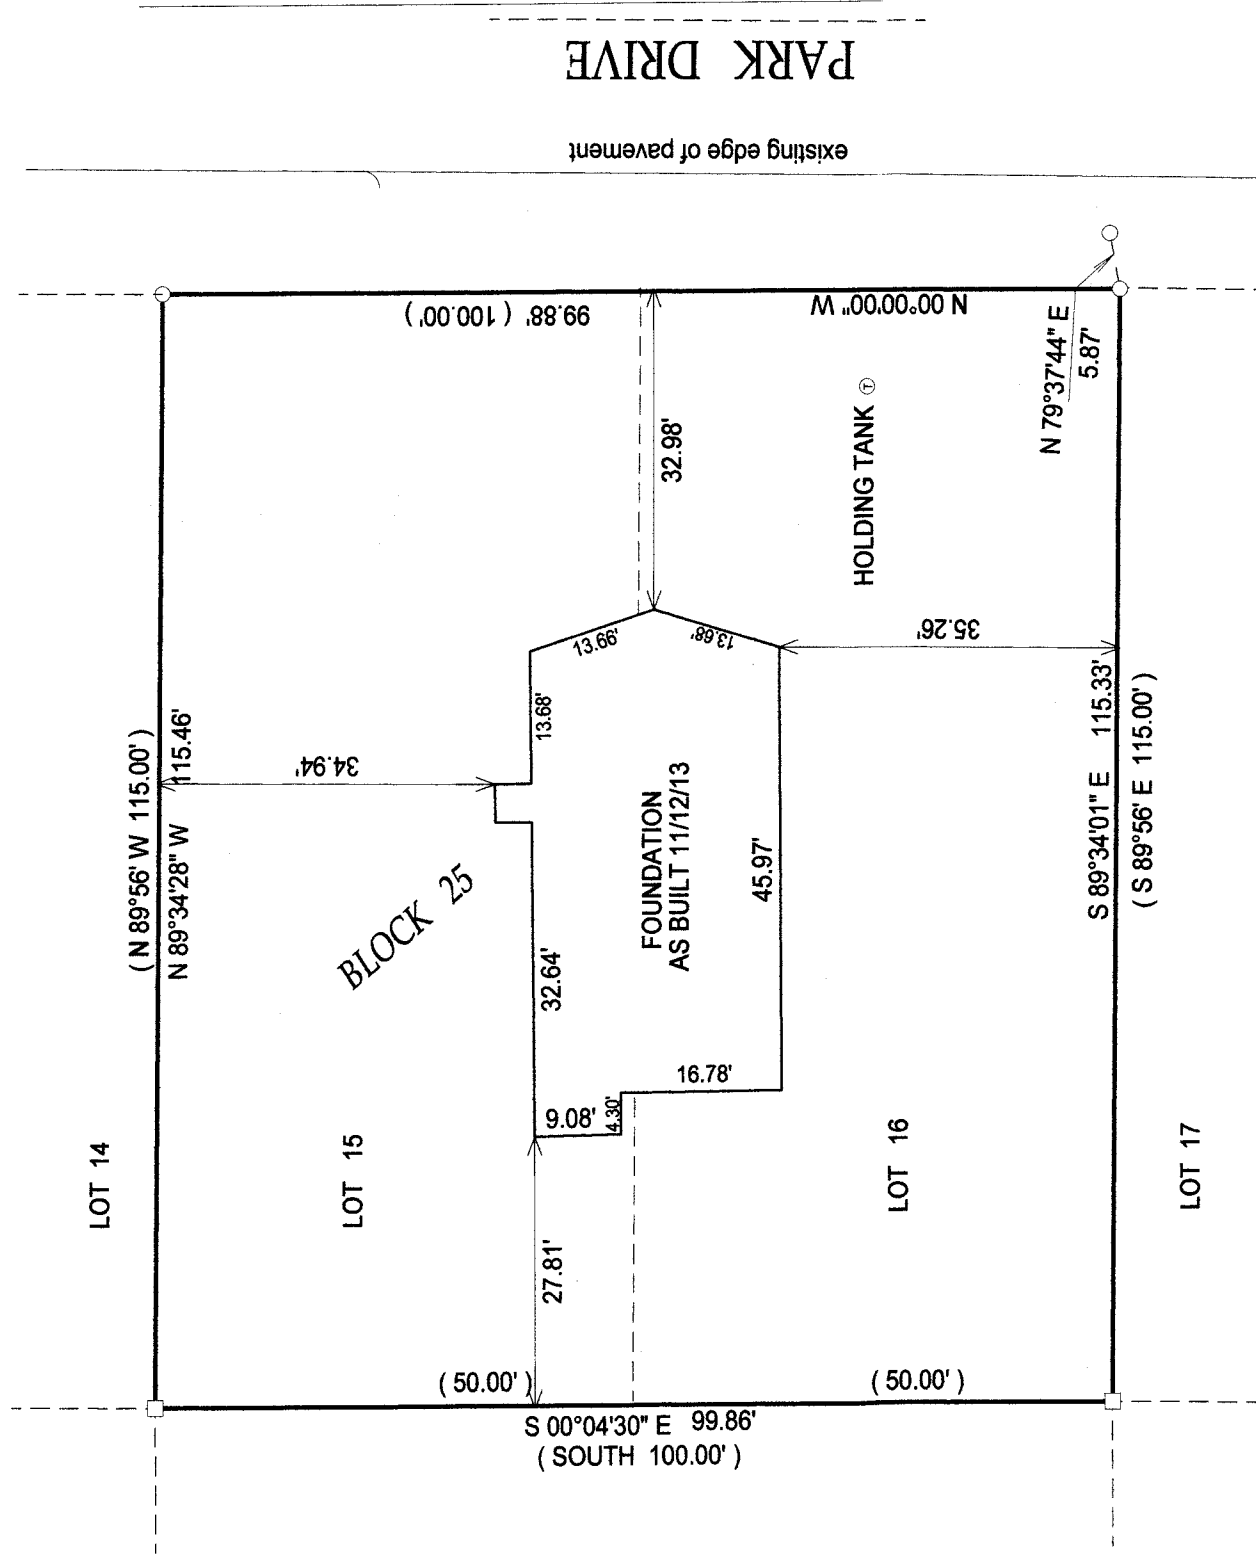

BASIS OF BEARING THE WEST LINE OF PARK DRIVE WAS ASSUMED
TO BEAR NORTH AS SHOWN ON THE RECORD PLAT.

I hereby certify that I have surveyed the above- described property and the
above map is a true representation thereof and shows the size and
location of the property, its exterior boundaries, the location and
dimensions of all structures thereon, fences, appurtenant easements and
roadways and visible encroachments if any.

This survey is made for the present owners of the property, and those who
purchase, mortgage, or guarantee the title thereto, within one year from
the date hereof.

JOB # 13-167PH

TAX ID # JSH00185

DATED THIS 11TH DAY OF SEPTEMBER, 2013.

REVISED 11/12/13
FOUNDATION AS BUILT

revised 10/29/2013
adjusted t/f and contours

revised 10-7-2013 added topo
and erosion control

REVISED 9/23/2013
ADDED PROPOSED HOUSE AND DECK



JEFFREY L. KIMPS S - 2436
Wisconsin Registered Land Surveyor
(original if signed in red)

JSH -185 217-3973