

PREPARED FOR:  
BASSO BUILDERS  
405 SKYLINE DRIVE  
LAKE GENEVA, WI 53147


# PLAT OF SURVEY

-OF-

LOTS 6414 THRU 6418, BLOCK 111, LAKE COMO BEACH  
SUBDIVISION, LOCATED IN SECTION 28, TOWN 2 NORTH, RANGE  
17 EAST, TOWN OF GENEVA, WALWORTH COUNTY, WISCONSIN.


LYNCH & ASSOCIATES  
ENGINEERING CONSULTANTS, LLC.

5482 S. WESTRIDGE DR.  
NEW BERLIN, WI 53151  
(262) 248-3697

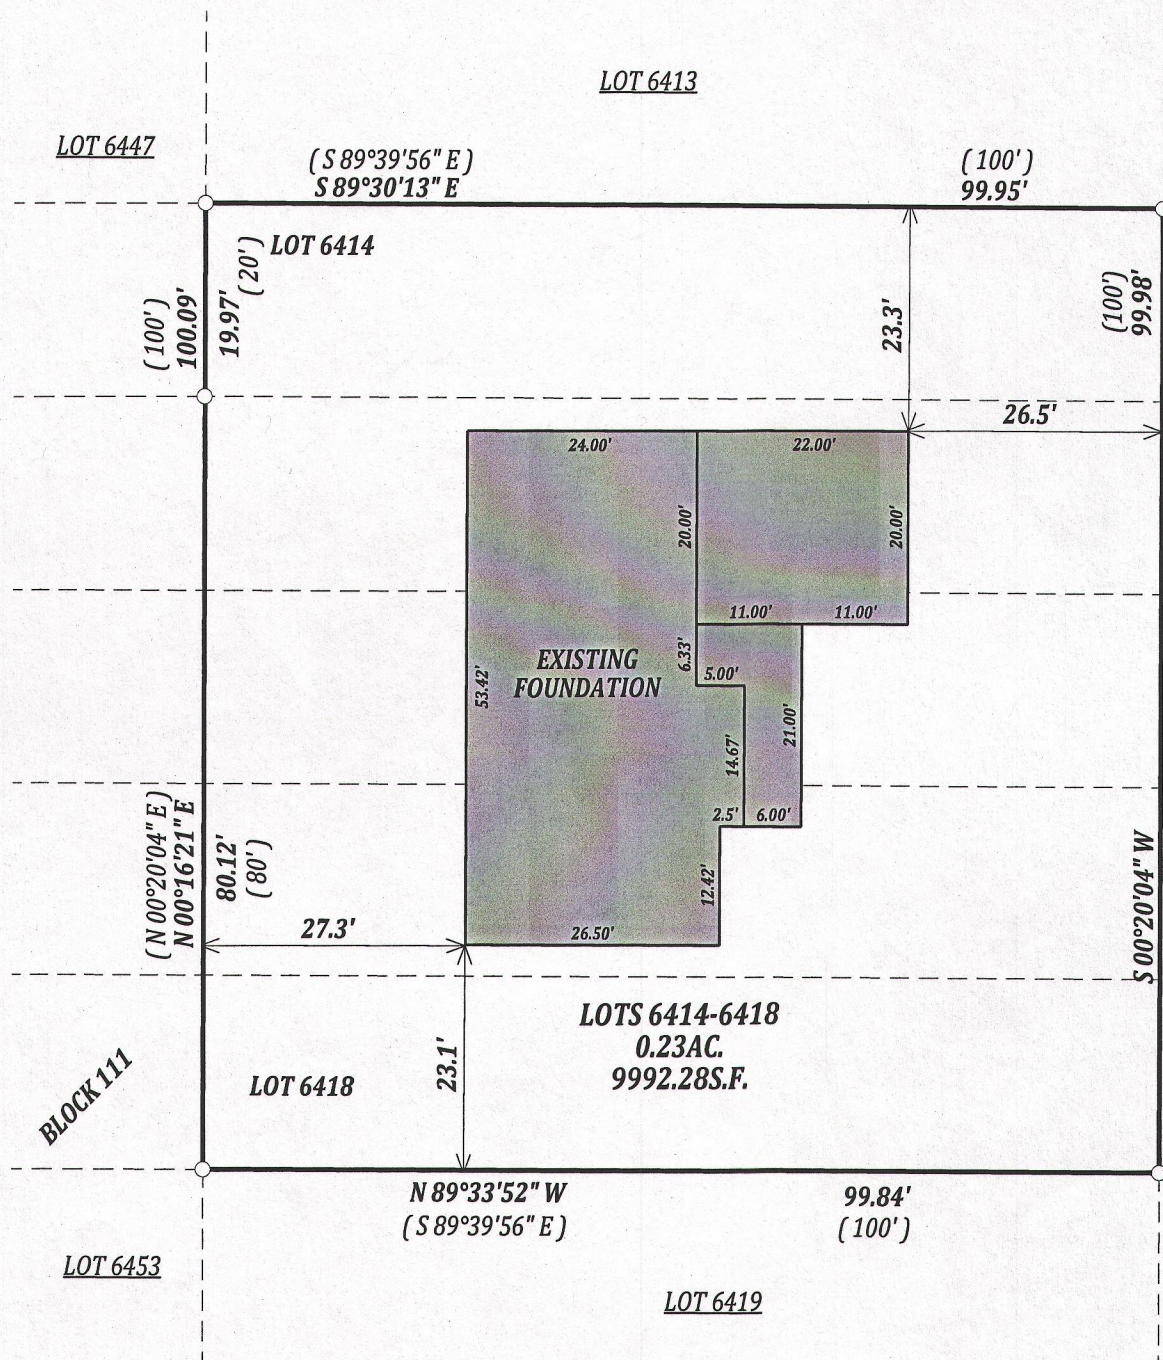



## LEGEND

- FOUND 1" IRON PIPE
- (XX) RECORDED AS

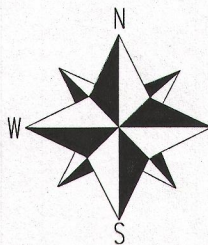

BEARINGS HEREON REFERENCED TO  
THE RECORDED PLAT

SCALE 1" = 20'

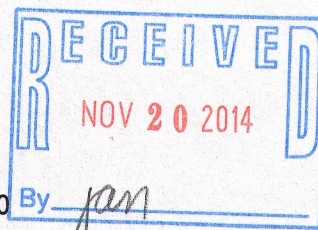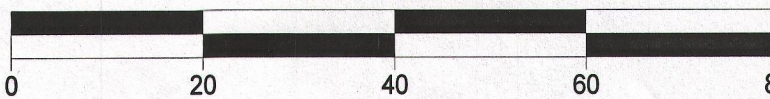

## NOTE:

No title commitment or results of a title search were provided to this office pertaining to this survey. This Plat Of Survey may not reflect easements of record, encumbrances, restrictions, ownership, title evidence, or other facts that a current and accurate title search may disclose.

I have surveyed the above-described property and the above map is a true representation thereof and shows the size and location of the property, its exterior boundaries, the location and dimensions of all structures thereon, fences apparent easements and roadways and visible encroachments, if any.

This survey is made for the exclusive use of the present owners of the property, and also those who purchase, mortgage, or insure the title thereto within one (1) year from date hereof; and as to them I warrant the accuracy of said survey map.



DATED THIS 26TH DAY OF JUNE 2014  
LAST REVISED THIS 8TH DAY OF AUGUST, 2014

KENNETH B. MEHRING S - 2838  
Wisconsin Registered Land Surveyor  
(original if signed in red)