

PREPARED FOR:
BEAA SHEEHAN
KEEFE REAL ESTATE, INC.
751 GENEVA PARKWAY
LAKE GENEVA, WI. 53147

SURVEY ADDRESS:
N3621 WILLOW BEND LANE


PLAT OF SURVEY

-OF-

LOT 9 WILLOW BEND PARK, A SUBDIVISION LOCATED IN THE
SOUTHWEST 1/4 AND THE SOUTHEAST 1/4 OF SECTION 15 AND THE
NORTHWEST 1/4 AND THE NORTHEAST 1/4 OF SECTION 22, TOWNSHIP
2 NORTH, RANGE 17 EAST, WALWORTH COUNTY, WISCONSIN.

LYNCH & ASSOCIATES
ENGINEERING CONSULTANTS, LLC.

5482 S. WESTRIDGE DR.
NEW BERLIN, WI 53151
(262) 248-3697

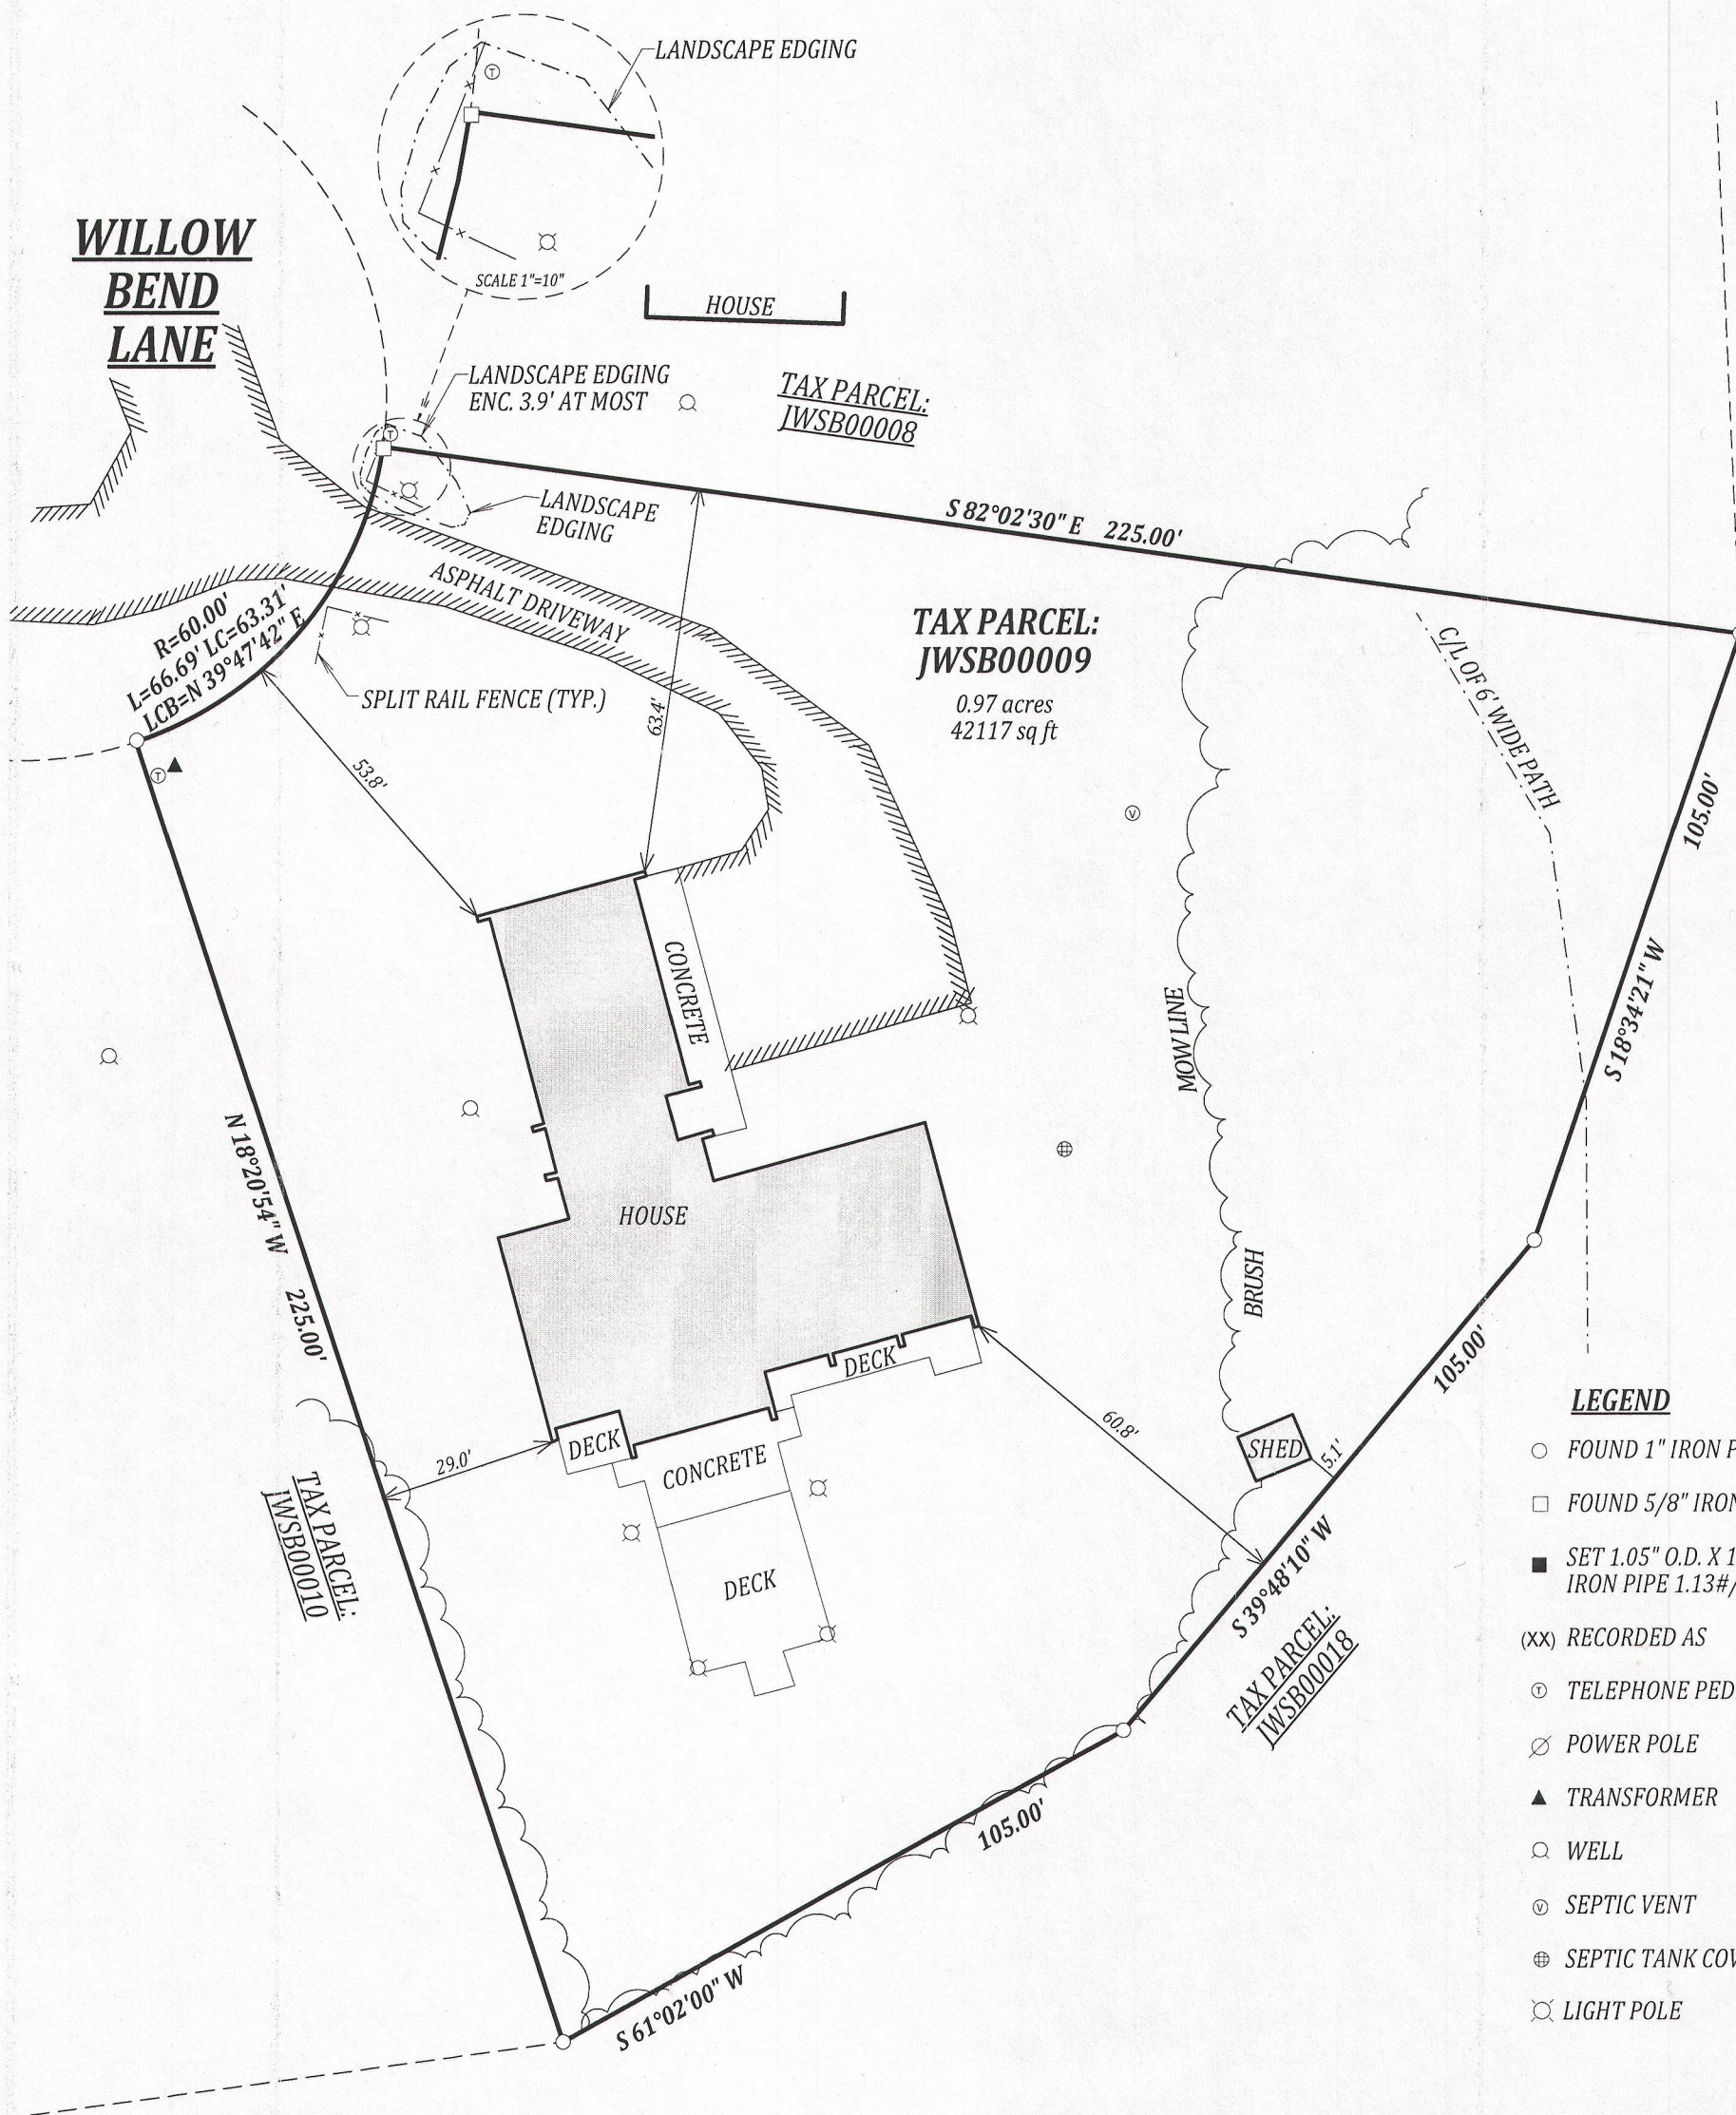

LEGEND

- FOUND 1" IRON PIPE
- FOUND 5/8" IRON ROD
- SET 1.05" O.D. X 18" IRON PIPE 1.13#/L.F.
- (XX) RECORDED AS
- ⊙ TELEPHONE PEDISTAL
- ⊗ POWER POLE
- ▲ TRANSFORMER
- WELL
- ⊙ SEPTIC VENT
- ⊕ SEPTIC TANK COVER
- LIGHT POLE



RECEIVED
NOV 20 2014
By Jan


WISCONSIN
KENNETH B. MEHRING
S-2838
WATERFORD
WIS.
LAND SURVEYOR

DATED THIS 31st DAY OF MARCH 2014
KENNETH B. MEHRING S-2838
Wisconsin Registered Land Surveyor
(original if signed in red)

I have surveyed the above-described property and the above map is a true representation thereof and shows the size and location of the property, its exterior boundaries, the location and dimensions of all structures thereon, fences apparent easements and roadways and visible encroachments, if any.

This survey is made for the exclusive use of the present owners of the property, and also those who purchase, mortgage, or insure the title thereto within one (1) year from date hereof; and as to them I warrant the accuracy of said survey map.

JOB # 14-516
TAX ID # JWSB 00009

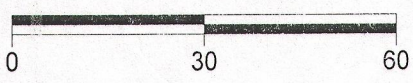

JWSB-9 217-4013