

HAROLD H. KOLB

REGISTERED PROFESSIONAL LAND SURVEYOR

LAKE GENEVA, WISCONSIN

Right-of-way post on corner;
set iron pipe 1.00' South of
corner on line

PLAT OF SURVEY OF

Lots 291-304 and 326-338,
Block 7, Lake Como Beach
Subdivision, T 2 N, R 17 E,
Walworth County, Wisconsin.

Owner: Elaine M. Vollmar



Date of Survey: June 24, 1974



SCALE: 1"=60'

LEGEND

- ⊕ - IRON PIPE FOUND
- - IRON PIPE PLACED
- - CONCRETE MONUMENT
- x - SPIKE

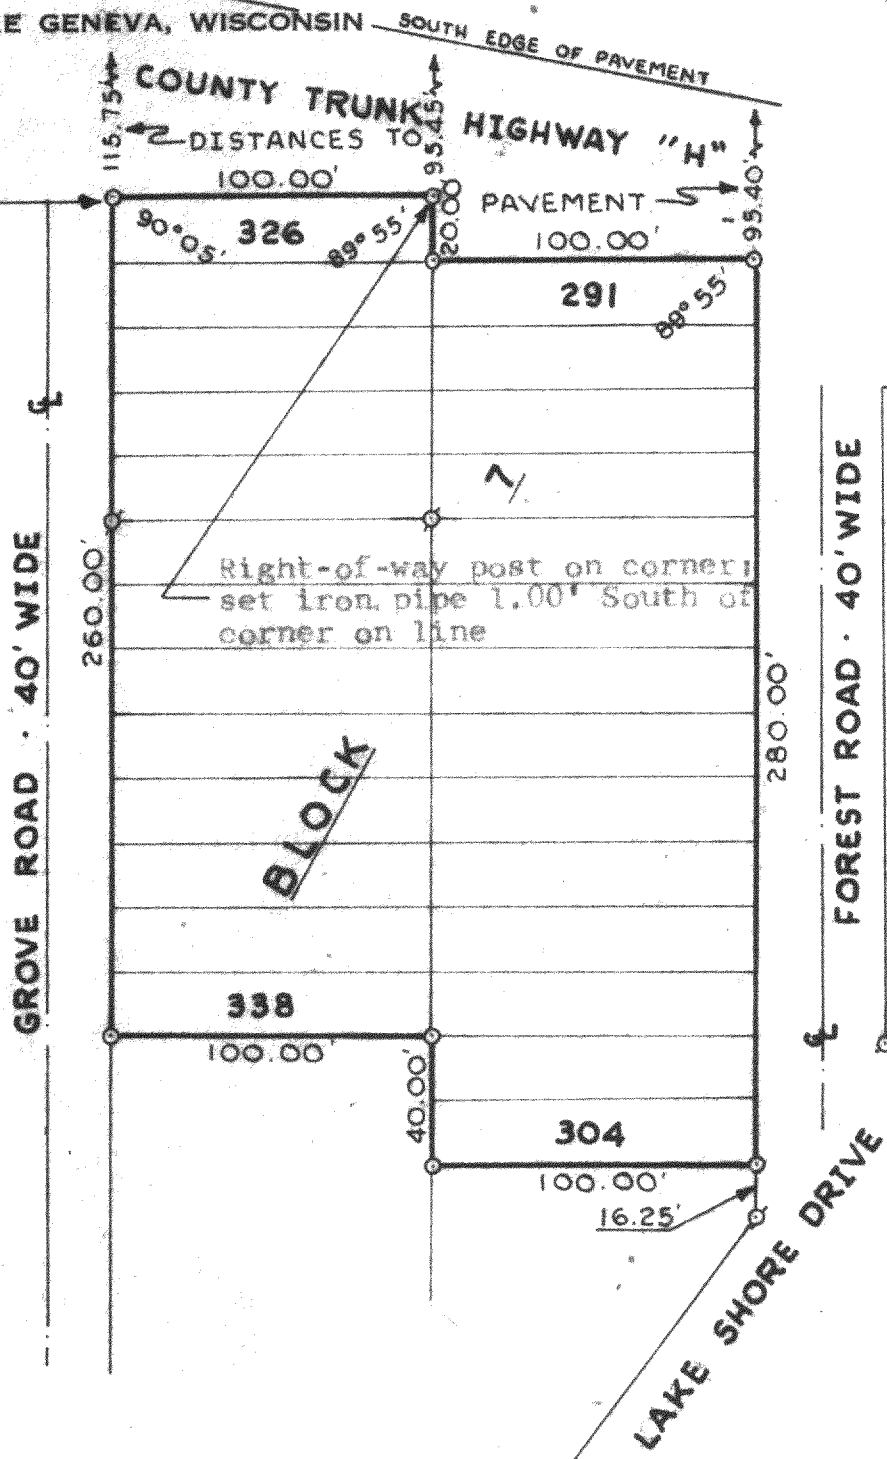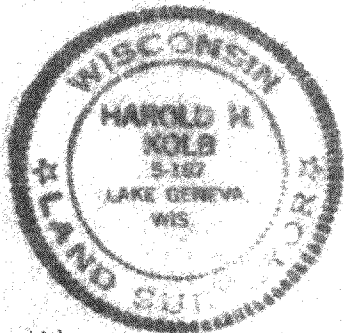

I, HAROLD H. KOLB, DO HEREBY CERTIFY THAT I HAVE SURVEYED THE PROPERTY HEREON DESCRIBED ACCORDING TO THE OFFICIAL RECORDS, AND THAT THE PLAT HEREON IS A CORRECT REPRESENTATION OF THE LOT LINES.

Harold H. Kolb

HAROLD H. KOLB
WISCONSIN REGISTERED LAND SURVEYOR, S-187

DATE July 2, 1974

JLCB-41,45

217-402