PREPARED FOR: **BASSO BUILDERS 405 SKYLINE DRIVE** LAKE GENEVA, WI 53147


SURVEY PLAT

-OF-

LYNCH & ASSOCIATES ENGINEERING CONSULTANTS, LLC.

405 SKYLINE DRIVE, SUITE C LAKE GENEVA, WI 53147 (262) 248-3697

LOTS 6419 THRU 6421, BLOCK 111, LAKE COMO BEACH SUBDIVISION, LOCATED IN SECTION 28, TOWN 2 NORTH, RANGE 17 EAST, TOWN OF GENEVA, WALWORTH COUNTY, WISCONSIN.

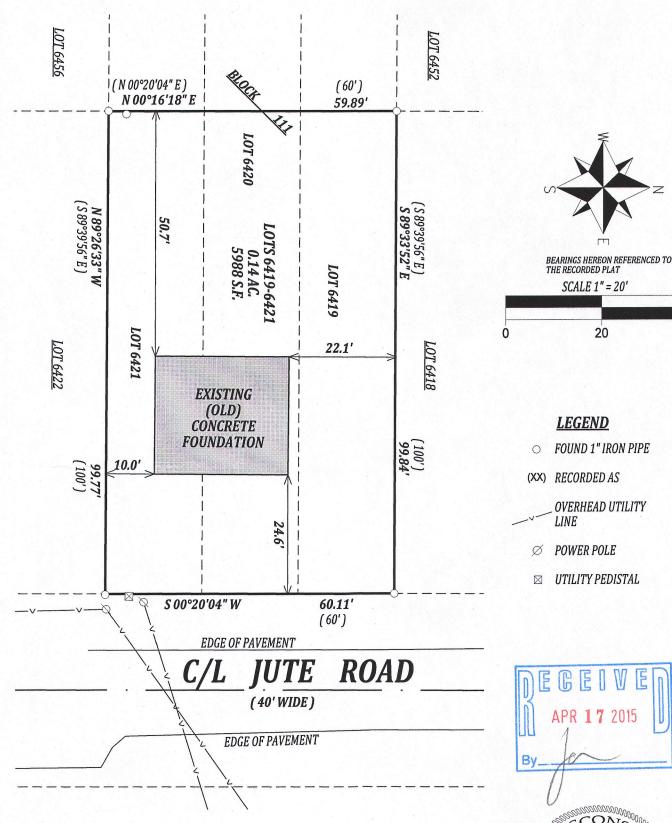


No title commitment or reults of a title search were provided to this office pertaining to this survey. This Plat Of Survey may not reflect easements of record, encumbrances, restrictions, ownership, title evidence, or other facts that a current and accurate title search may disclose.

I have surveyed the above-described property and the above map is a true representation thereof and shows the size and location of the property, its exterior boundaries, the location and dimensions of all structures thereon, fences apparent easements and roadways and visible encroachments. if any.

This survey is made for the exclusive use of the present owners of the property, and also those who puchase, mortgage, or insure the

title therto within one (1) year from date hereof; and as to them I warrant the accuracy of said survey map.

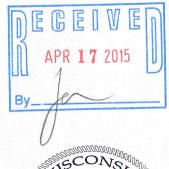



DATED THIS 28TH DAY OF JANUARY, 2015

KENNETH B. MEHRING S - 2838 Wisconsin Registered Land Surveyor (original if signed in red)

JOB # 15-507 TAX ID # JLCB01331

JLCB-1331

217-4064