PLAT OF SURVEY

- OF -

PREPARED FOR ELAINE JOHNSON KEEFE REAL ESTATE LAKE GENEVA WI

LOT 1 OF MAPLE TREE FARMS A SUBDIVISION OF PART OF THE NORTHWEST 1/4 , SOUTHWEST 1/4 AND SOUTHEAST 1/4 OF THE SOUTHEAST 1/4 OF SECTION 33, TOWNSHIP 2 NORTH, RANGE 17 EAST, TOWN OF GENEVA, COUNTY OF WALWORTH AND STATE OF WISCONSIN.

PATHFINDER SURVEYING INC.


(formerly)


J.K. SURVEYING INC.

P.O BOX 322

LAKE GENEVA, WI. 53147

WWW.PATHFINDERSURVEYING.NET
262-248-8303

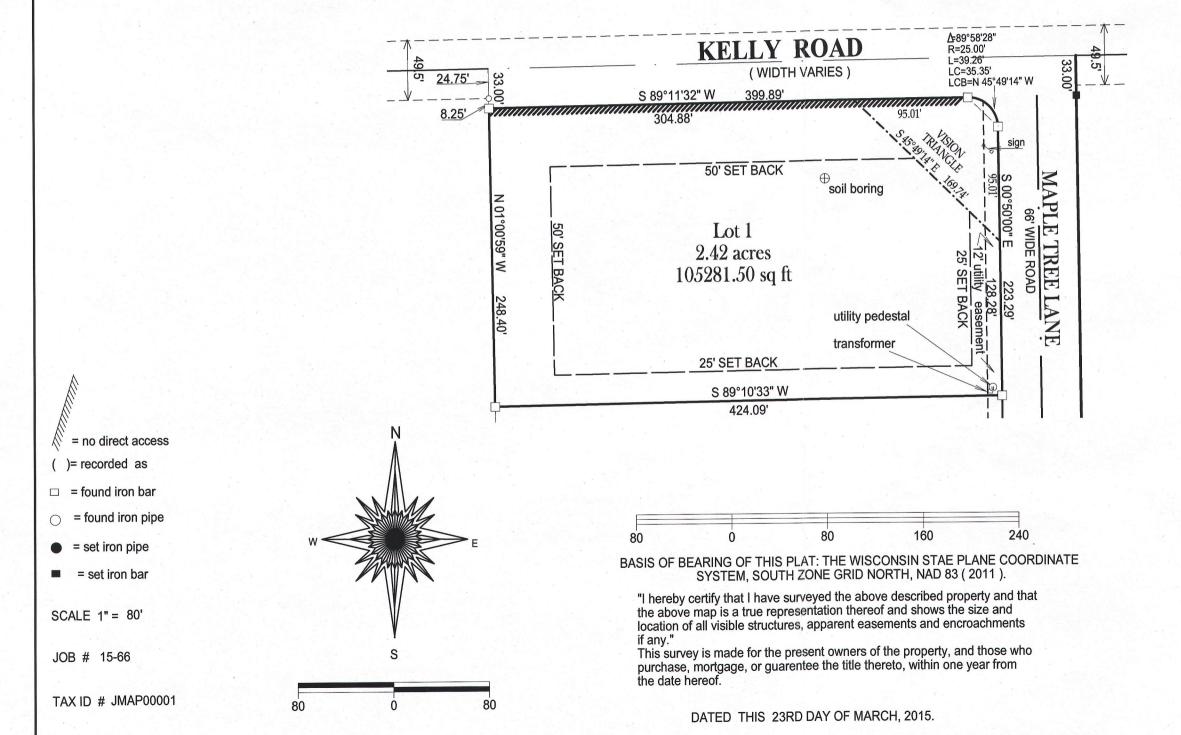

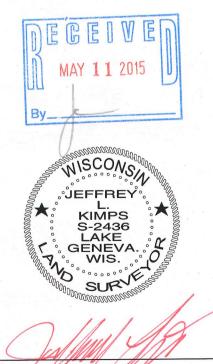

JEFFREY L KIMPS S - 2436 Wisconsin Registered Land Surveyor (original if signed in red)