



APR 01 2015

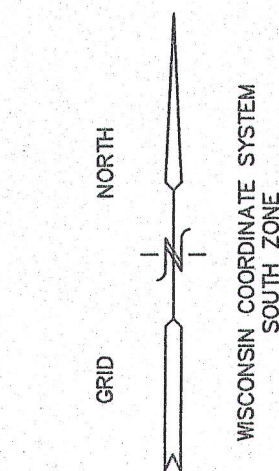

18-17

18-18
25,879 S.F.

GOLF CLUB GROUNDS

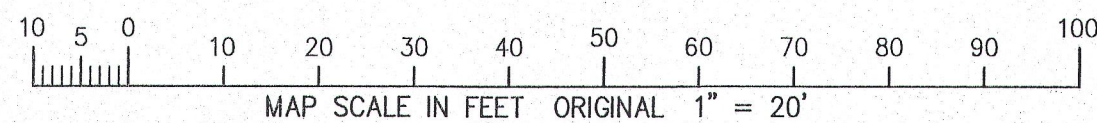

N 63°25'11" E
186.89

10' SIDE YARD

12.2

16.0

18.3

18.7

10.6

18.4

10.6

9.7

30.0

7.0

14.2

29.8

54.8

54.99

N 80°55'42" W

198.07

N 48°05'46" W

50' GOLF CLUB SETBACK

50' GOLF CLUB SETBACK

EXISTING RESIDENCE

PORCH

DECK

TRANSFORMER
C.A.T.V. BOX
ELECT. BOX

HYDRANT

SANITARY MANHOLE
RIM EL. = 1013.05'
IE = 997.81'

12" WATER MAIN

8" SAN. SEWER

GENEVA CLUB DRIVE


66' EIDE PRIVATE ROADWAY

C=2271.23
A=2301.94
R=371.13
S=05°45'14" E

Unit 18-18, together with said unit's undivided appurtenant interest in the common elements (and the exclusive use of the limited common elements appurtenant to said unit) all in Geneva National Condominium No. 18, a condominium declared and existing under and by virtue of the Condominium Ownership Act of the State of Wisconsin and recorded by a Declaration as such condominium in the Office of the Register of Deeds for Walworth County, Wisconsin, on May 30, 1990, in Volume 488 of Records at pages 247 through 295, as Document No. 154851, said condominium being located in the Town of Geneva, County of Walworth, State of Wisconsin on the real estate described in said Declaration and incorporated herein by this reference thereto;

Tax Key No. JGN 1800018

● = FOUND IRON REBAR STAKE
(xxx) = RECORDED AS


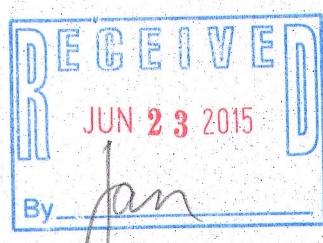


NOTE: COPIES OF THIS MAP TO WHICH THE FOLLOWING CERTIFICATE WILL APPLY SHOW THE SURVEYOR'S ORIGINAL SEAL AND SIGNATURE IN RED INK. COPIES BY ANY OTHER MEANS MAY HAVE ALTERATIONS WHICH DO NOT REPRESENT THE SURVEYOR'S WORK PRODUCT.

I HEREBY CERTIFY THAT THE ABOVE DESCRIBED PROPERTY HAS BEEN SURVEYED UNDER MY DIRECTION AND THAT THE ABOVE MAP IS A TRUE REPRESENTATION THEREOF AND SHOWS THE SIZE AND LOCATION OF THE PROPERTY, ITS EXTERIOR BOUNDARIES, THE LOCATION OF ALL VISIBLE STRUCTURES, AND DIMENSIONS OF ALL PRINCIPLE BUILDINGS THEREON, BOUNDARY FENCES, APPARENT EASEMENTS, ROADWAYS, AND VISIBLE ENCROACHMENTS, IF ANY. THIS SURVEY IS MADE FOR THE USE OF THE PRESENT OWNERS OF THE PROPERTY, AND ALSO THOSE WHO PURCHASE, MORTGAGE, OR GUARANTEE THE TITLE THERETO WITHIN ONE YEAR FROM THE DATE HEREOF.

DATED: MARCH 26, 2015

PETER S. GORDON
S-2101
ELKHORN, WI
PETER S. GORDON P.L.S. 2101

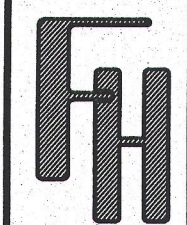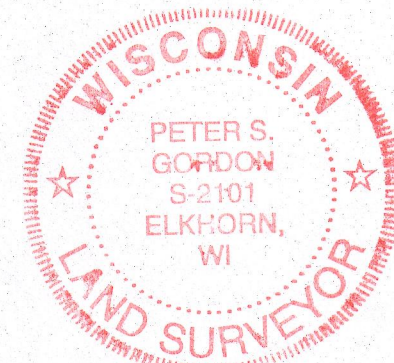

WORK ORDERED BY SCOTT LOWELL
LOWELL MANAGEMENT
P.O. BOX 926
LAKE GENEVA, WI. 53147

FARRIS, HANSEN & ASSOCIATES, INC.
Engineering, Architecture, Surveying
7 Ridgway Court P.O. Box 437
ELKHORN, WISCONSIN 53121
Office: (414) 723-2098
Fax: (414) 723-5886

REVISIONS

PROJECT NO.
3269.18-18
DATE:
10-25-99
SHEET NO.
1 OF 1

JGN 18-18 217-4080