PREPARED FOR: William & Michelle Ziegler 6320 w. Peterson Ave. Chicago, Il. 60646


## PLAT **OF SURVEY**


-OF-

LOTS 10443, 10444, 10445, 10446 AND 10447 IN BLOCK 189, LAKE COMO BEACH FIFTH MAP, SECTION 28, T2N, R17E, TOWN OF GENEVA, WALWORTH COUNTY, WISCONSIN.

## LYNCH & ASSOCIATES ENGINEERING CONSULTANTS, LLC.

405 SKYLINE DRIVE, SUITE C LAKE GENEVA, WI 53147 (262) 248-3697

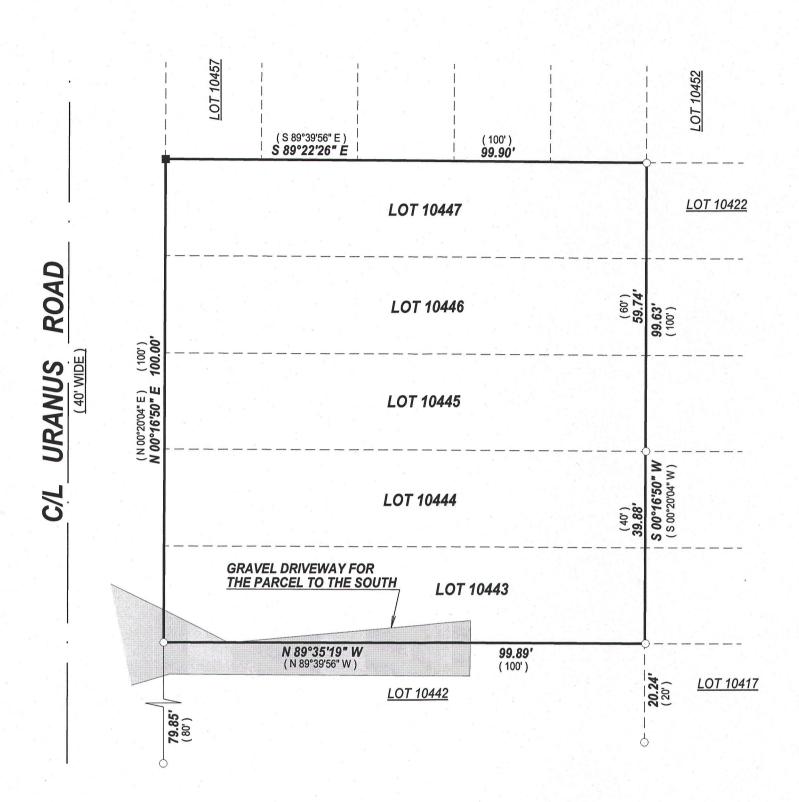

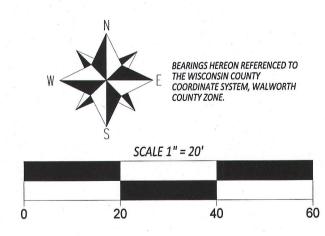

## **LEGEND**

- O FOUND 1" IRON PIPE
- ☐ FOUND 5/8" IRON BAR
- SET 5/8" O.D. X 18" IRON BAR 1.13#/L.F.

(XX) RECORDED AS



## NOTE:

No title commitment or reults of a title search were provided to this office pertaining to this survey. This Plat Of Survey may not reflect easements of record, encumbrances, restrictions, ownership, title evidence, or other facts that a current and accurate title search may disclose.

I have surveyed the above-described property and the above map is a true representation thereof and shows the size and location of the property, its exterior boundaries, the location and dimensions of all structures thereon, fences apparent easements and roadways and visible encroachments. if any.

This survey is made for the exclusive use of the present owners of the property, and also those who puchase, mortgage, or insure the title therto within one (1) year from date hereof; and as to them I warrant the accuracy of said survey map.



DATED THIS 8th DAY OF MAY, 2015

**KENNETH B. MEHRING S - 2838** Wisconsin Professional Land Surveyor (original if signed in red)