
PREPARED FOR CHUCK PLATTS SHOREWEST REALTY LAKE GENEVA WI

PLAT OF SURVEY


- OF -

PATHFINDER SURVEYING INC.
(formerly)
J.K. SURVEYING INC.
P.O BOX 322
LAKE GENEVA, WI. 53147
WWW.PATHFINDERSURVEYING.NET
262-248-8303

PART OF LOTS 33 AND 34 OF WILDWOOD SUBDIVISION, ACCORDING TO THE RECORD PLAT THEREOF, DESCRIBED AS FOLLOWS: LOTS 33 AND 34 OF WILDWOOD SUBDIVISION, EXCEPT THE WEST 65 FEET OF LOT 34 OF WILDWOOD. ALSO INCLUDES A PARCEL OF LAND SITUATED IN WILDWOOD SUBDIVISION, LOCATED IN TOWN 2 NORTH, RANGE 17 EAST, MORE PARTICULARY DESCRIBED AS FOLLOWS: COMMENCING AT THE SOUTHWEST CORNER OF ,OT 34 WILDWOOD SUBDIVISION; THENCE PROCEED S 89°19' E 65.00 FEET TO THE POINT OF BEGINNING OF THE PARCEL HERIN DESCRIBED: THENCE PROCEED N 0°41' E 228.46 FEET; THENCE N 89°19' W 15.00 FEET; THENCE S 0°41' W, 228.46 FEET; THENCE S 89°19' E, 15.00 FEET TO THE PLACE OF BEGINNING. EXCEPTING A PARCEL OF LAND SITUATED IN WILDWOOD SUBDIVISION IN TOWN 2 NORTH, RANGE 17 EAST, DESCRIBED AS FOLLOWS: COMMENCING AT THE NORTHWEST CORNER OF LOT 34 OF WILDWOOD SUBDIVISION; THENCE PROCEED S 89°19' E 65.00 FEET TO THE POINT OF BEGINNING OF THE PARCEL HEREIN DESCRIBED; THENCE PROCEED S 89°19' E 60.00 FEET; THENCE S 0°41' W 40.00 FEET; THENCE S 62°37' W, 68.00 FEET; THENCE N 0°41' W, 72.00 FGEET TO THE PLACE OF BEGINNING. SAID LAND BEING IN THE TOWN OF GHENEVA, COUNTY OF WALWORTH AND STATE OF WISCONSIN.

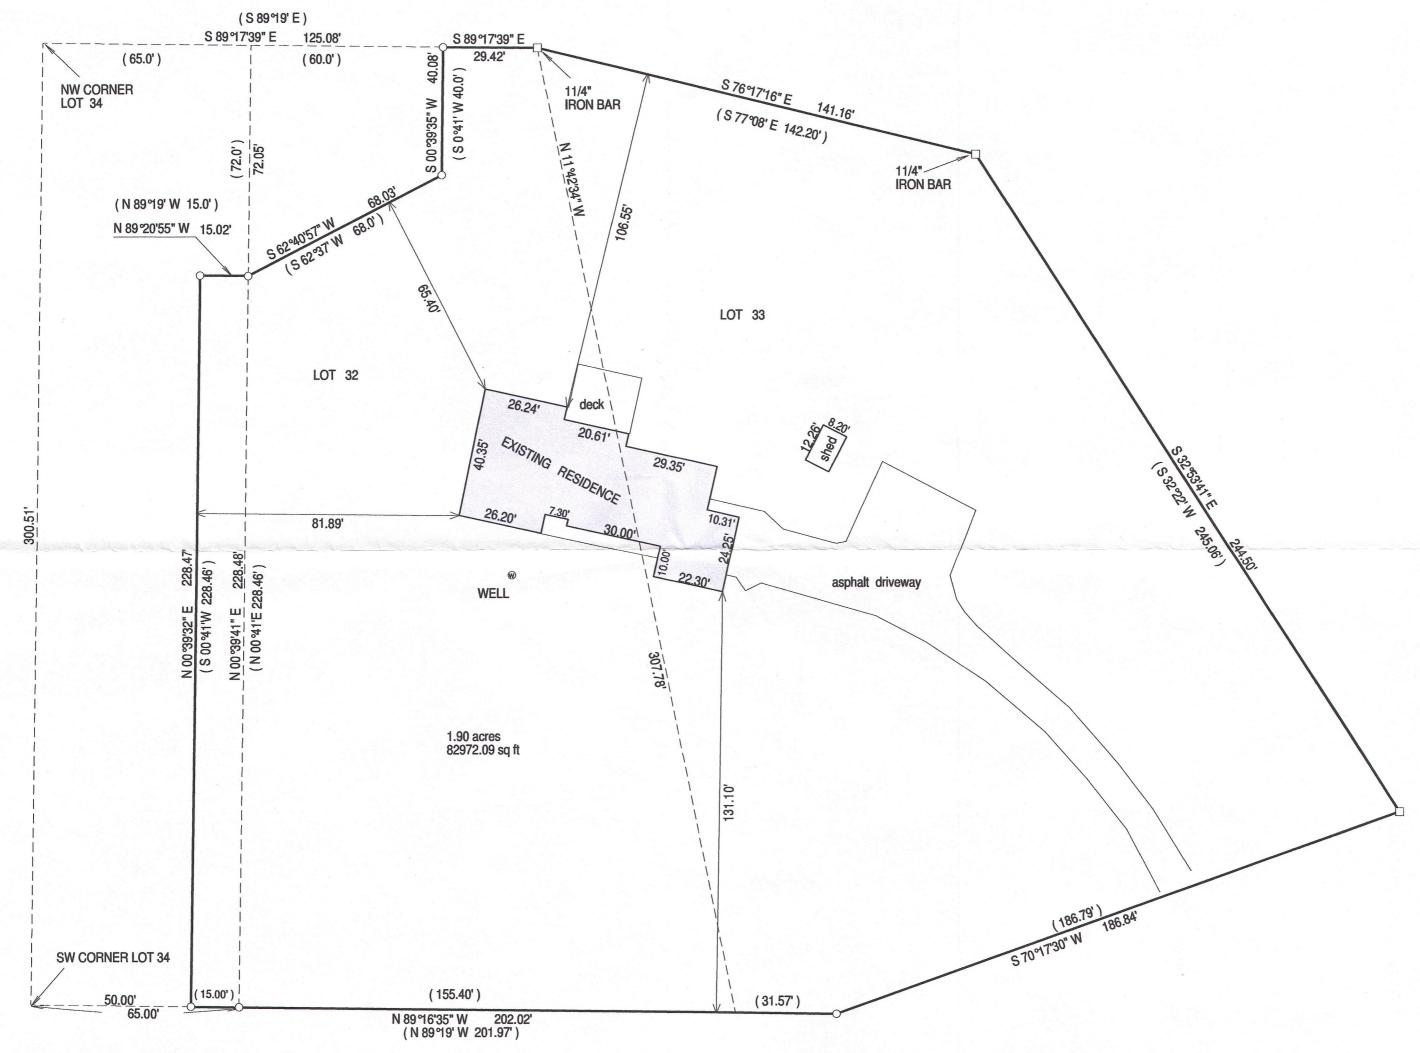

WILDWOOD DRIVE

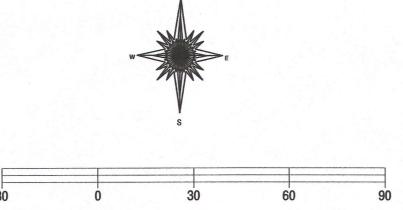


BASIS OF BEARING OF THIS PLAT: THE SUBDIVISION PLAT OF RECORD.

I hereby certify that I have surveyed the above- described property and the above map is a is a true representation thereof and shows the size and location of the property, its exterior boundaries, the location and dimensions of all structures thereon, fences, apparant easements and roadways and visible encroachments if any.

This survey is made for the present owners of the property, and those who purchase, mortgage, or guarantee the title thereto, within one year from the date hereof.

DATED THIS 10TH DAY OF JUNE, 2015.

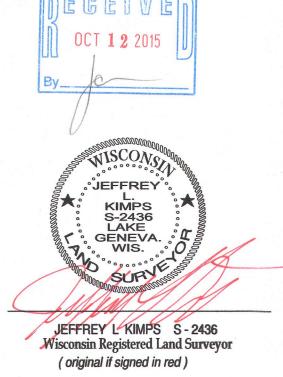

TAX ID # JWS 00032

()= recorded as

= found iron bar

= found iron pipe

= set iron pipe

= set iron bar

SCALE 1" = 20'

JOB # 15-180