

# DEGEN - FOAT SURVEYING, INC.


100 SOUTH SECOND STREET  
WATERFORD, WISCONSIN 53185  
(262)534-5404 (FAX)534-2022

159024  
159024S1.DWG

## PLAT OF SURVEY

LOT 1 OF CERTIFIED SURVEY MAP NO. 3651 AS RECORDED IN VOLUME 21 OF CERTIFIED SURVEYS ON PAGES 327 THRU 329 OF WALWORTH COUNTY RECORDS, LOCATED IN PART OF THE NORTHWEST 1/4 AND SOUTHWEST 1/4 OF THE SOUTHEAST 1/4 OF SECTION 9, TOWN 2 NORTH, RANGE 17 EAST, TOWN OF GENEVA, WALWORTH COUNTY, WISCONSIN.


\* REFER TO A CURRENT TITLE REPORT FOR EASEMENTS, RESTRICTIONS OR COVENANTS OF RECORD THAT MAY AFFECT THIS LAND. \*

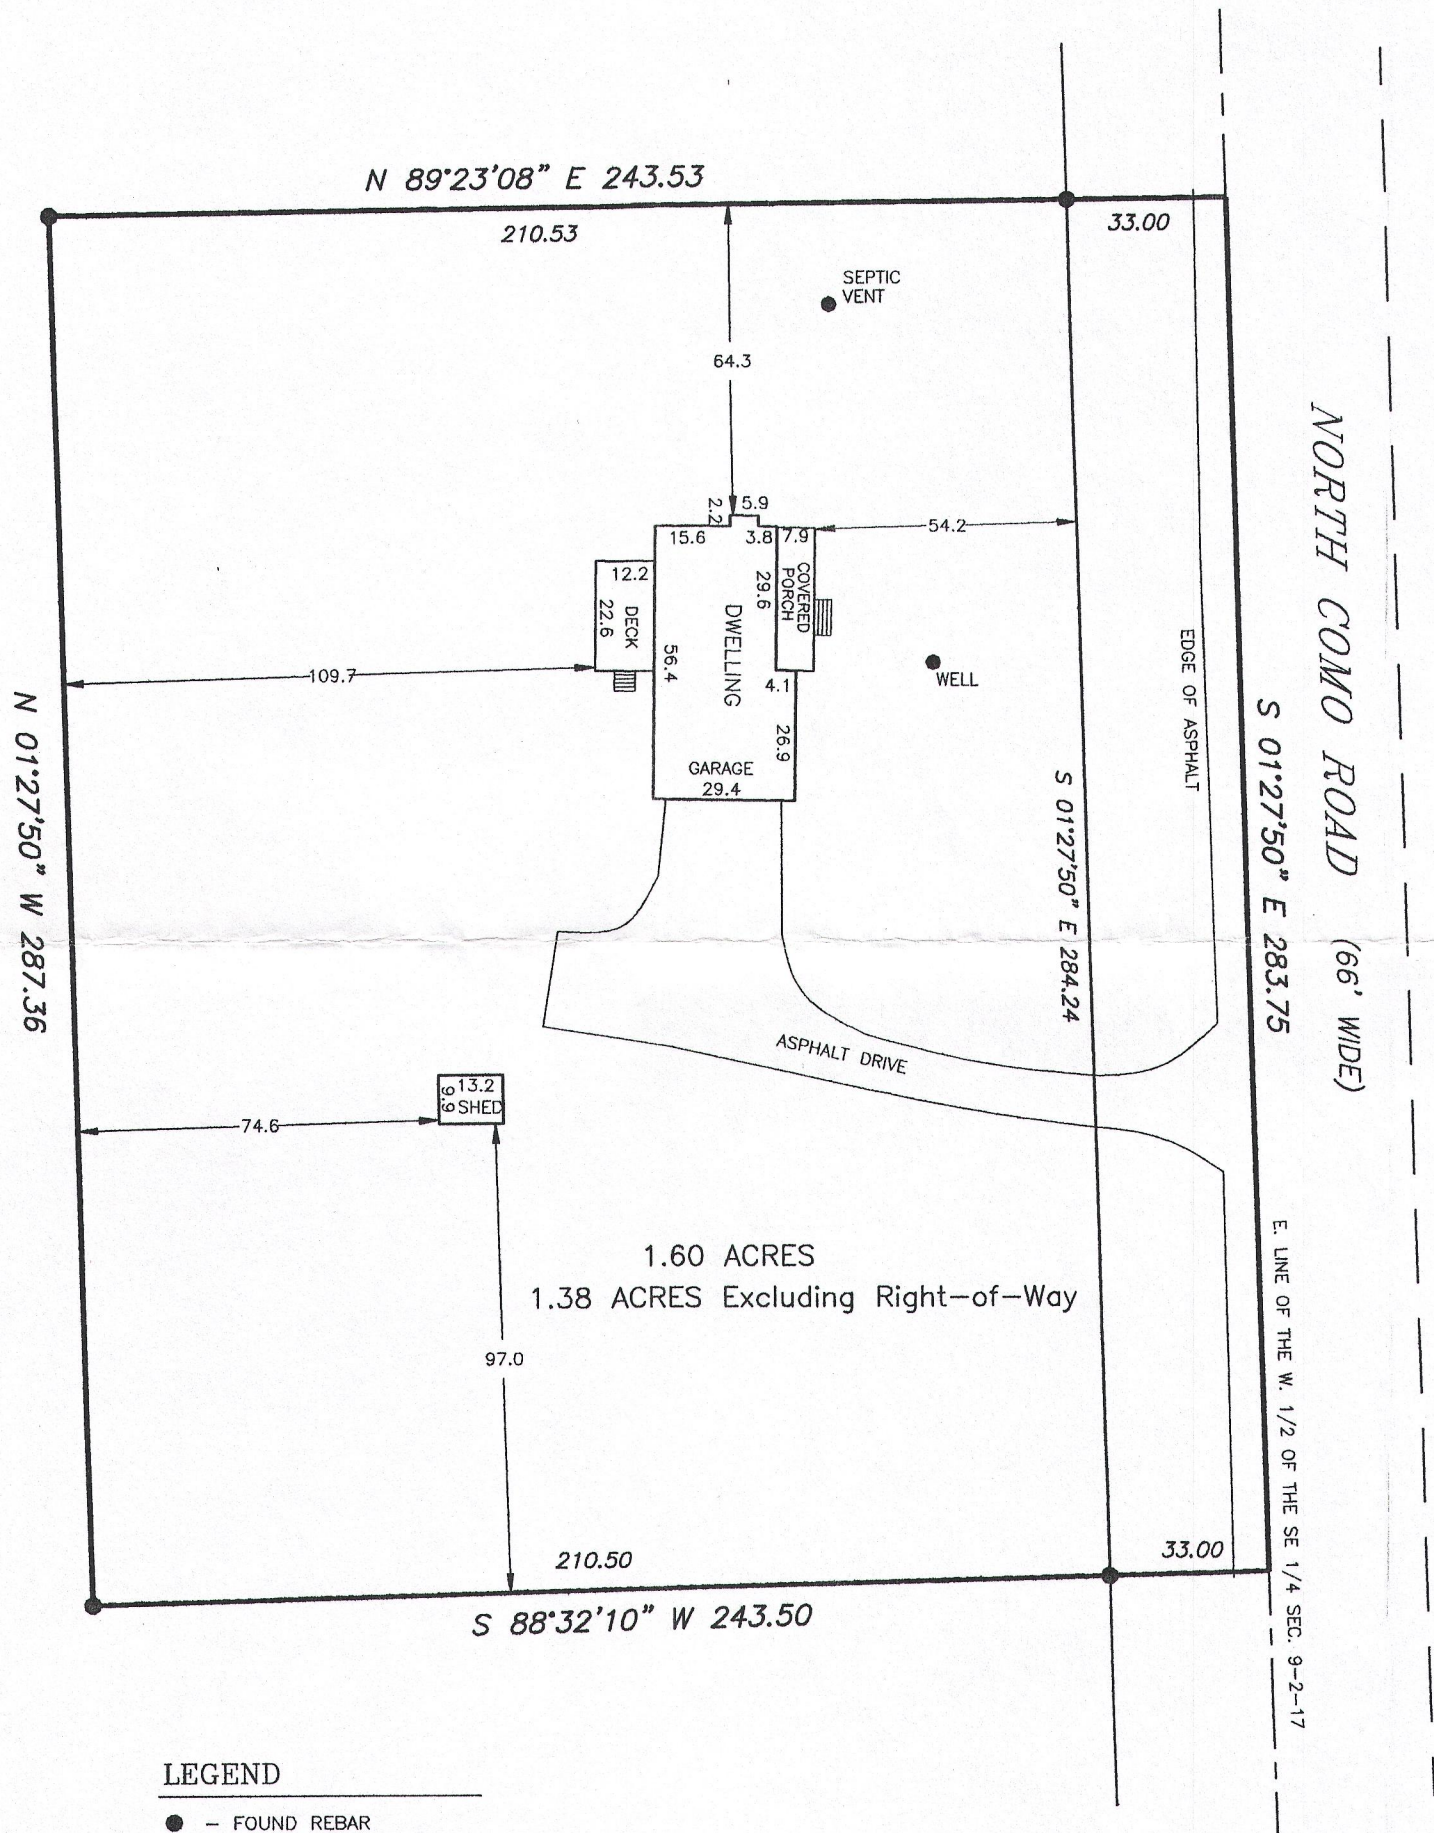

### LEGEND

- - FOUND REBAR
- ( ) - RECORDED AS

SCALE: 1" = 40'  
BEARING BASE: AS RECORDED AS.

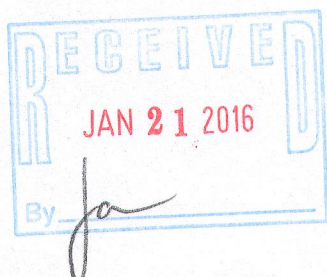

SURVEY PREPARED FOR: ROCH TRANEL  
1010 SANDSTONE DRIVE  
LIBERTYVILLE, IL 60048

I HEREBY CERTIFY THAT I HAVE SURVEYED THE ABOVE DESCRIBED PROPERTY AND THE ABOVE MAP IS A TRUE REPRESENTATION THEREOF AND SHOWS THE SIZE AND LOCATION OF THE PROPERTY, THE LOCATION OF ALL VISIBLE STRUCTURES AND DIMENSIONS OF ALL PRINCIPAL BUILDINGS THEREON, BOUNDARY FENCES, APPARENT EASEMENTS, ROADWAY AND VISIBLE ENCROACHMENTS, IF ANY.

THIS SURVEY IS MADE FOR THE PRESENT OWNERS OF THE PROPERTY, AND ALSO THOSE WHO PURCHASE, OR GUARANTEE THE TITLE THERETO WITHIN (1) YEAR FROM THE DATE HEREOF.

DATED AT WATERFORD, WI THIS 14th DAY OF APRIL 2015

RECERTIFIED

*Gary B. Foat*