

DESCRIBED PROPERTY AND THAT THE ABOVE MAP IS A CORRECT REPRESENTATION THEREOF AND SHOWS THE SIZE AND LOCATION OF THE PROPERTY, ITS EXTERIOR BOUNDARIES, THE LOCATION OF ALL VISIBLE STRUCTURES AND DIMENSIONS OF ALL PRINCIPAL BUILDINGS THEREON, BOUNDARY FENCES, APPARENT EASEMENTS, ROADWAYS AND ENCROACHMENTS, IF ANY."

"THIS SURVEY IS MADE FOR THE USE OF THE PRESENT OWNERS OF THE PROPERTY, AND THOSE WHO PURCHASE, MORTGAGE, OR GUARANTEE THE TITLE THERETO WITHIN ONE YEAR FROM DATE

SATTER SURVEYING, LLC

LAND SURVEYS, MAPPING AND PLANNING 272 ORIGEN STREET BURLINGTON, WI 53105

262-661-4239

SURVEY FOR: JOHN GIAMPOLI OF OMEGA HOMES SURVEY ADDRESS: 1362 GENEVA NATIONAL AVENUE EAST, LAKE GENEVA, WI, 53147

UNIT 22-02 IN GENEVA NATIONAL CONDOMINIUM NO. 22 CONDOMINIUM

CREATED BY A "DECLARATION OF CONDOMINIUM" RECORDED ON JUNE 1.

WISCONSIN, IN VOLUME 488 OF RECORDS, PAGE 499, AS DOCUMENT NO.

194918, AND ANY AMENDMENTS AND/OR CORRECTIONS THERETO, AND BY

ITS CONDOMINIUM PLAT AND ANY AMENDMENTS AND/OR CORRECTIONS THERETO. SAID LAND BEING IN THE TOWN OF GENEVA, COUNTY OF

WALWORTH, STATE OF WISCONSIN.

1990, IN THE OFFICE OF THE REGISTER OF DEEDS FOR WALWORTH COUNTY,

SANITARY SEWER MANHOLE RIM ELEVATION = 881.37'


ENT

LEGEND

FOUND IRON ROD

RECORDED AS

BEARINGS HEREON RELATE TO THE NORTHERLY LINE OF UNIT 22-02. ASSUMED BEARING OF NORTH 89°32'04" EAST AS PLATTED.

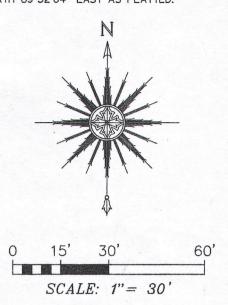

NOTE: REFER TO A CURRENT TITLE REPORT FOR EASEMENTS, RESTRICTIONS OR COVENANTS WHICH MAY AFFECT THIS PROPERTY.



THIS IS NOT AN ORIGINAL PRINT UNLESS THIS SEAL IS RED.

homas I. Sa THOMAS L. SATTER S-2850

FEBRUARY 23, 2016 DATE

021607 JOB NUMBER