
FARRIS, HANSEN, & ASSOCIATES, INC.

ENGINEERING, ARCHITECTURE, SURVEYING
7 RIDGWAY COURT - P.O. BOX 437, ELKHORN, WISCONSIN, 53121

PHONE: (262) 723-2098 FAX: (262) 723-5886

PLAT OF SURVEY

THE NORTH 1/2 OF LOT 10143 & LOTS 10144 THRU 10146 OF BLOCK 185 LAKE COMO BEACH SUBDIVISION

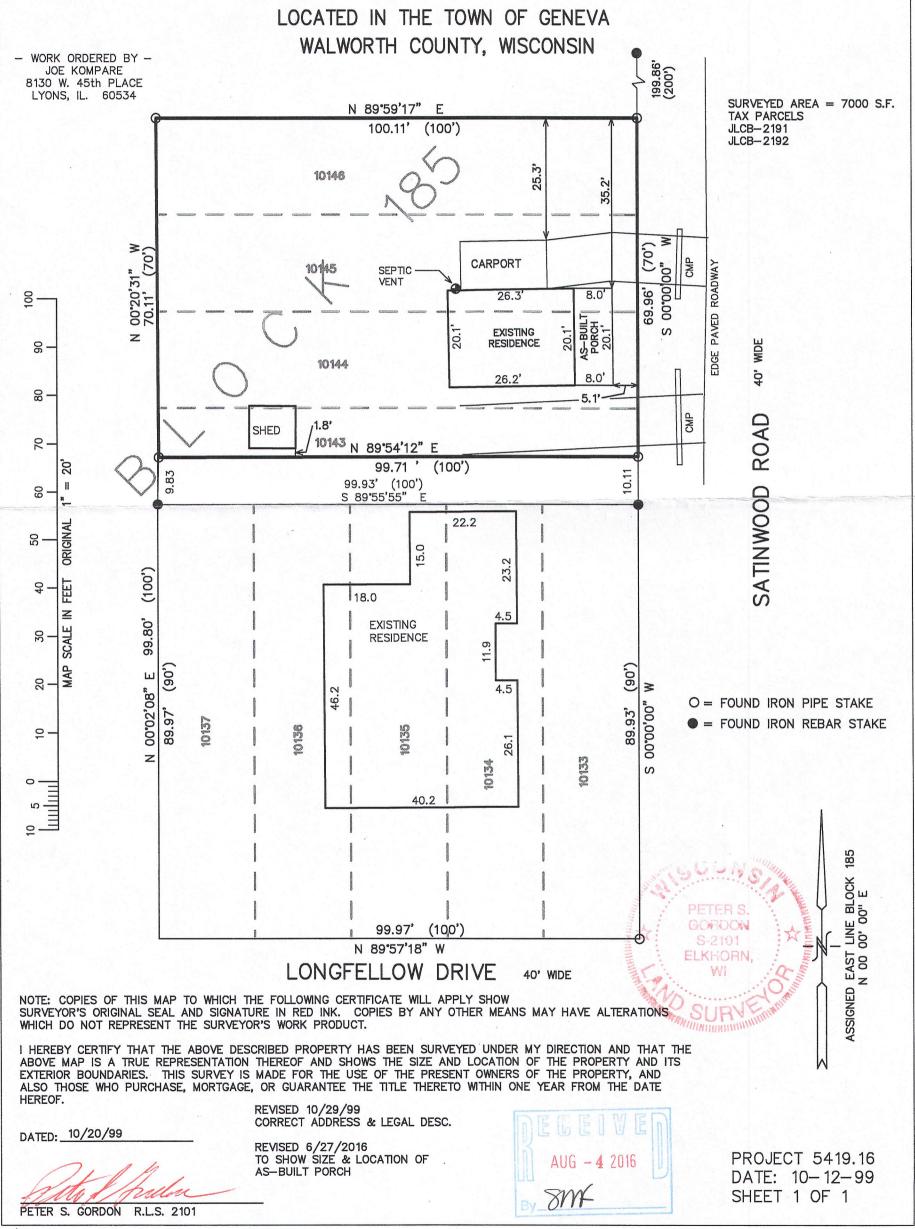

JLCB-2191