



# PLAT OF SURVEY

- OF -



PATHFINDER SURVEYING INC.  
(formerly )  
J.K. SURVEYING INC.  
P.O BOX 322  
LAKE GENEVA, WI. 53147  
WWW.PATHFINDERSURVEYING.NET  
262-248-8303

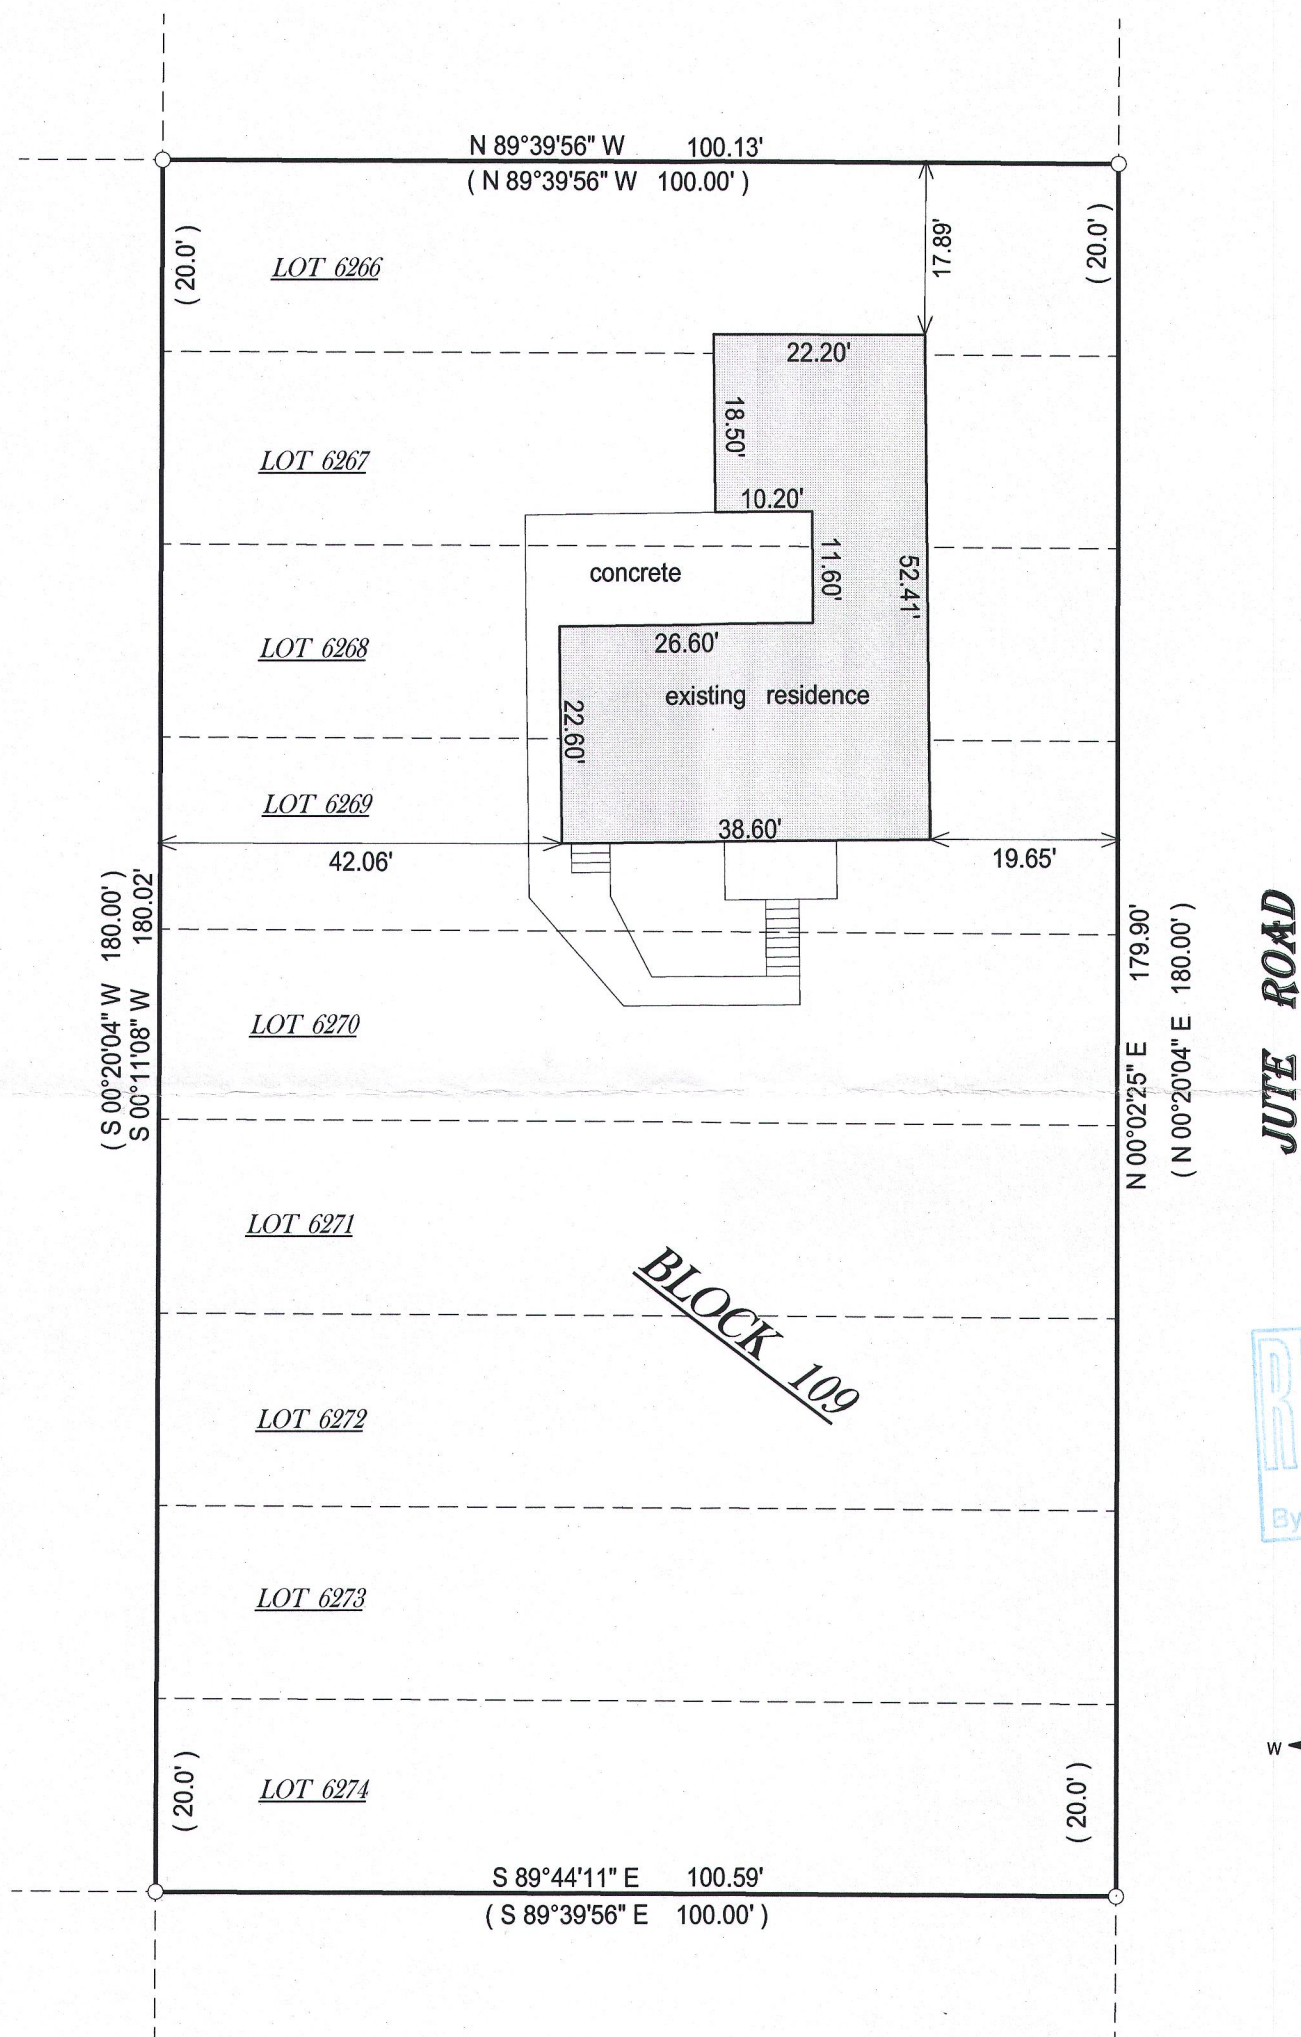

JLCB 01298

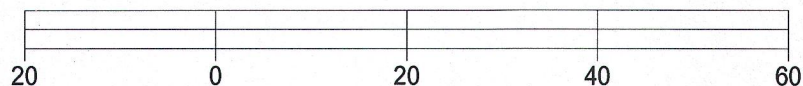

DATED THIS 26TH DAY OF MARCH, 2016.

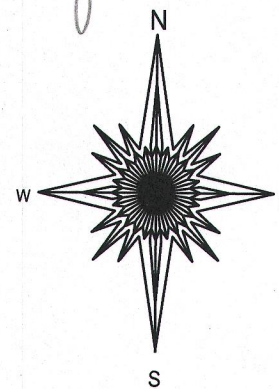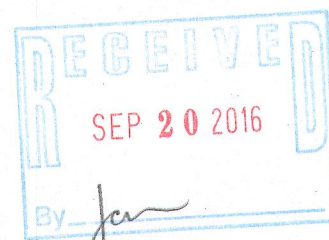

JEFFREY L KIMPS S -2436  
Wisconsin Professional Land Surveyor  
( original if signed in red )