

LAND-MARK SURVEYING

Mark L. Miritz

Wisconsin Professional Land Surveyor S-2582

N9330 Knuteson Drive
Whitewater, WI 53190
Phone: (262) 495-3284
MarkMiritz@
Land-MarkSurveying.com

PLAT OF SURVEY

LEGAL DESCRIPTION

LOTS 7462 THRU 7470 INCLUSIVE, IN BLOCK 128, LAKE COMO BEACH

LOCATED IN THE NORTHEAST 1/4 OF THE NORTHWEST 1/4,
SECTION 26, TOWNSHIP 2 NORTH, RANGE 17 EAST, IN THE
TOWN OF GENEVA, WALWORTH COUNTY, WISCONSIN

OWNER:

DIANE M. GRAZZINI TRUST AND
FRANK A. MAZZONE TRUST, ETAL
243 LORRAINE CIR.
BLOOMINGDALE, IL. 60108

WOODLAND DR.


MH
RIM ELEV. 962.3
(D=12.3')

(100')
100.02'

CORNER FALLS IN
6" DIA. STEEL FENCE
POST

PROPOSED
DRIVE

OPAL RD.
(40' WIDE)

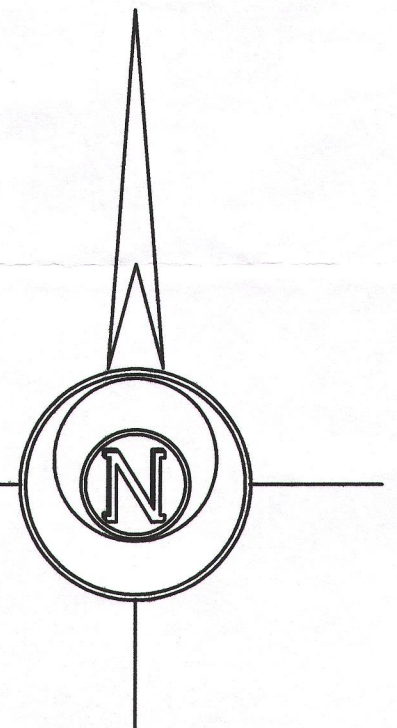


BASIS OF BEARINGS:
THE WEST LINE OF OPAL RD.
BEING S 00°20'04" W

LEGEND

- Ø FOUND IRON PIPE
- (xx) RECORDED AS DIMENSION
- X-X- EXISTING FENCE

SCALE: 1 INCH = 20 FEET

"I hereby certify that the above described property has been surveyed by me or under my direction and that the above map is a true representation thereof and shows the size and location of the property, its exterior boundaries, the location of all visible structures and dimensions of all principal buildings thereon, boundary fences, apparent easements, roadways and visible encroachments, if any."
"This survey is made for the use of the present owners of the property, and also those who purchase, mortgage, or guarantee the title thereto within one year from date hereof."

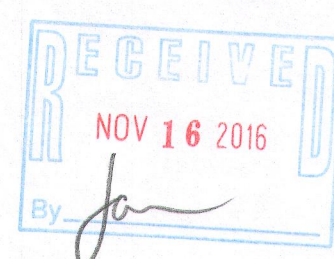

REVISED OCT. 25, 2016 TO
SHOW RESIDENCE "AS BUILT"

Mark L. Miritz
MARK L. MIRITZ
WISCONSIN PROFESSIONAL
LAND SURVEYOR S-2582

MAY 15, 2016

11.500