PREPARED FOR BEN & SHOKOTAKAHASI BLOEDE N3145 HICHORY, RD LAKE GENEVA, WI. 53147

PLAT OF SURVEY

- OF -

PATHFINDER SURVEYING INC.

(formerly)


J.K. SURVEYING INC.


P.O BOX 322

LAKE GENEVA, WI. 53147

WWW.PATHFINDERSURVEYING.NET
262-248-8303

LOTS 6013 THRU 6017, BLOCK 105, LAKE COMO BEACH, A SUBDIVISION LOCATED IN TOWN 2 NORTH, RANGE 17 EAST, TOWN OF GENEVA, COUNTY OF WALWORTH AND STATE OF WISCONSIN.

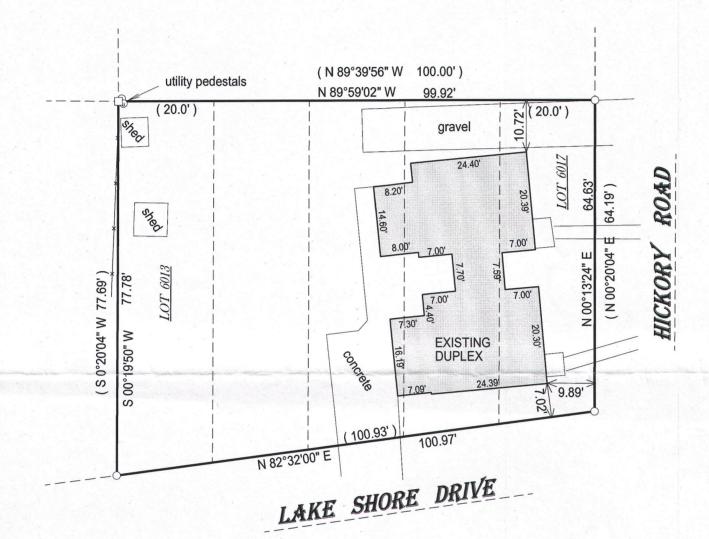

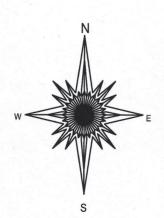

()= recorded as

□ = found iron bar

= found iron pipe

= set iron pipe

= set iron bar

SCALE 1" = 20'

JOB # 16-206

TAX ID # JLCB 01237



BASIS OF BEARING OF THIS PLAT: THE NORTH LINE OF LAKE SHORE DR. WAS ASSUMJED TO BEAR N 82°32'00" E.

I hereby certify that I have surveyed the above-described property and the above map is a is a true representation thereof and shows the size and location of the property, its exterior boundaries, the location and dimensions of all structures thereon, fences, apparant easements and roadways and visible encroachments if any.

This survey is made for the present owners of the property, and those who purchase, mortgage, or guarantee the title thereto, within one year from the date hereof

DATED THIS 11TH DAY OF JULY, 2016.





JEFFREY KIMPS S - 2436 Wisconsin Professional Land Surveyor (original if signed in red)