PREPARED FOR MELANIE VENEMA SHOREWEST REALTY LAKE GENEVA WI.


## **PLAT OF SURVEY**


OF


LOTS 5044-5048 BLOCK 89 OF LAKE COMO BEACH SUBDIVISION; LOCATED IN TOWN 2 NORTH, RANGE 17 EAST, WALWORTH COUNTY, WISCONSIN

PATHFINDER SURVEYING INC. (formerly) J.K. SURVEYING INC. P.O BOX 322 LAKE GENEVA, WI. 53147 WWW.PATHFINDERSURVEYING.NET 262-248-8303

WOODLAND DRIVE C.L.

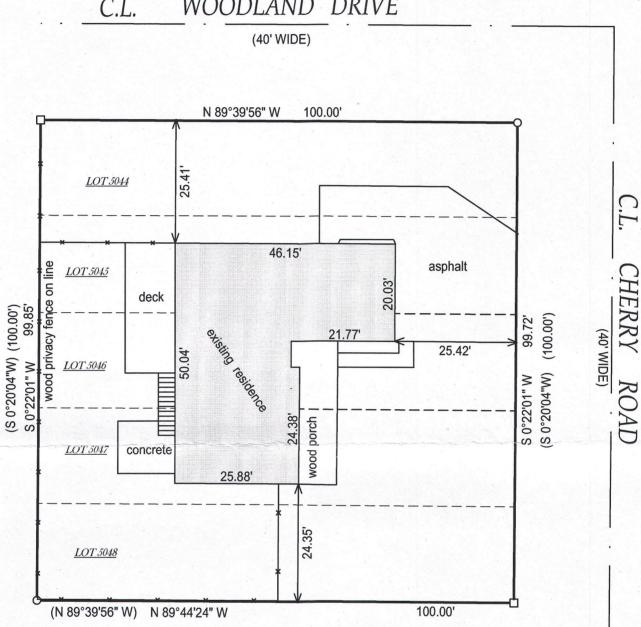

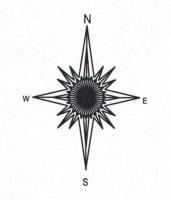

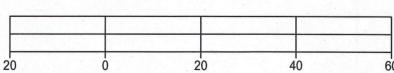

BASIS OF BEARING OF THIS PLAT: THE SUBDIVISION PLAT OF RECORD.

= found iron pipe "I hereby certify that I have surveyed the above described property and that the above map is a true representation thereof and shows the size and location of all visible structures, apparent easements and encroachments

This survey is made for the present owners of the property, and those who purchase, mortgage, or guarantee the title thereto, within one year from

the date hereof.

JEFFREY L KIMPS 8-2436 Wisconsin Professional Land Surveyor ( original if signed in red )

JAN 1 8 2017

NISCONS

WIS.

SURY

SCALE: 1"=20'

TAX KEY # JLCB-1013

( )= recorded as

□ = found iron bar

= set iron pipe

= set iron bar

JOB# 02-081ud

DATED THIS 13TH DAY OF OCTOBER, 2016.