
PREPARED FOR: LAKE GENEVA AREA REALTY 101 BROAD ST LAKE GENEVA, WI.

 
PLAT OF SURVEY

- OF -

PATHFINDER SURVEYING INC. (formerly) J.K. SURVEYING INC. P.O BOX 322 LAKE GENEVA, WI. 53147 WWW.PATHFINDERSURVEYING.NET 262-248-8303

LOT 16 OF WILDWOOD A SUBDIVISION, LOCATED IN THE NW 1/4 AND THE NE 1/4 OF SECTION 34, TOWN 2 NORTH, RANGE 17 EAST, TOWN OF GENEVA, COUNTY OF WALWORTH AND STATE OF WISCONSIN.

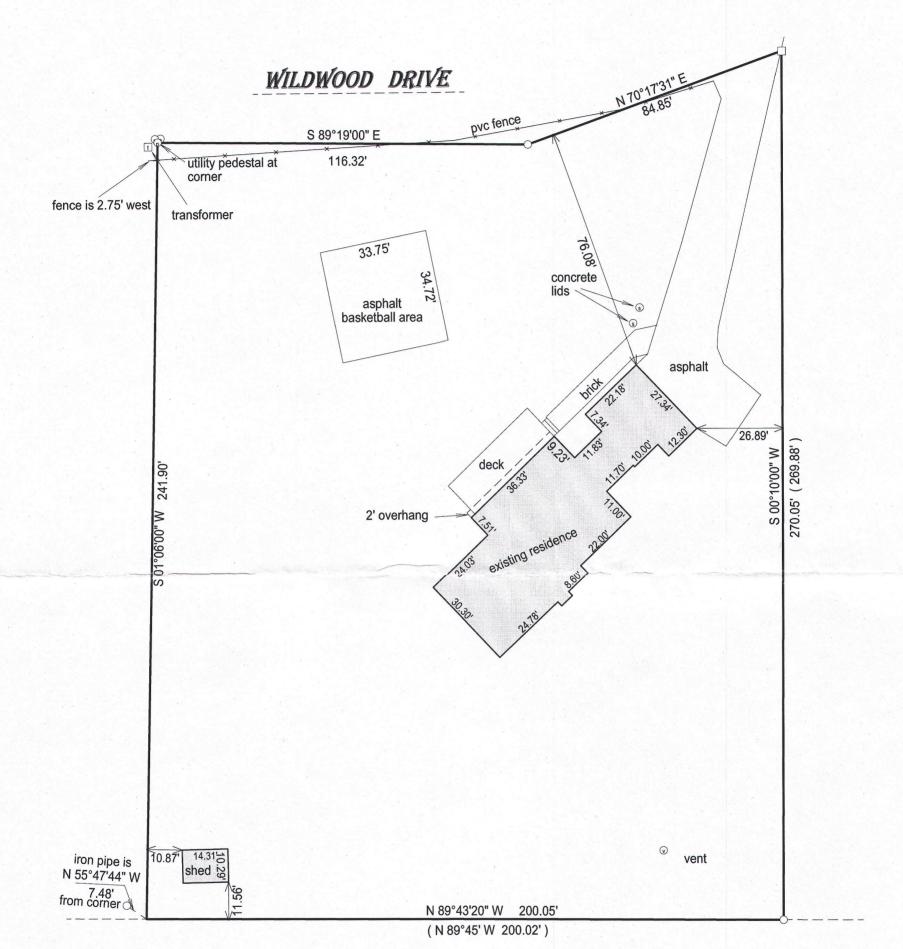



□ = found iron bar

= found iron pipe


= set iron pipe

= set iron bar

SCALE 1" = 30'

JOB # 16-273

TAX ID # JWS 00016

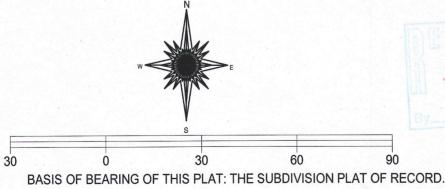

I hereby certify that I have surveyed the above- described property and the above map is a is a true representation thereof and shows the size and location of the property, its exterior boundaries, the location and dimensions of all structures thereon, fences, apparant easements and roadways and visible encroachments if any.

This survey is made for the present owners of the property, and those who purchase, mortgage, or guarantee the title thereto, within one year from the date hereof.

DATED THIS 5TH DAY OF SEPTEMBER, 2016.

JEFFREY L KIMPS S - 2436 Wisconsin Professional Land Surveyor

(original if signed in red)