

PREPARED FOR
MIKE PFAMMATTER
KEEFE RAL ESTATE
LAKE GENEVA, WI



PLAT OF SURVEY

- OF -

UNIT 3 OF GENEVA NATIONAL CONDOMINIUM No. 51 ADDENDUM No. 1,
LOCATED IN PART OF THE NW 1/4 OF THE SE 1/4 OF SECTION 19,
TOWN 2 NORTH, RANGE 17 EAST, TOWN OF GENEVA, COUNTY OF
WALWORTH AND STATE OF WISCONSIN.

(see attached for complete description)

PATHFINDER SURVEYING INC.
(formerly)
J.K. SURVEYING INC.
P.O BOX 322
LAKE GENEVA, WI. 53147
WWW.PATHFINDERSURVEYING.NET
262-248-8303

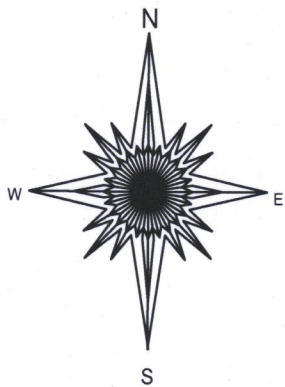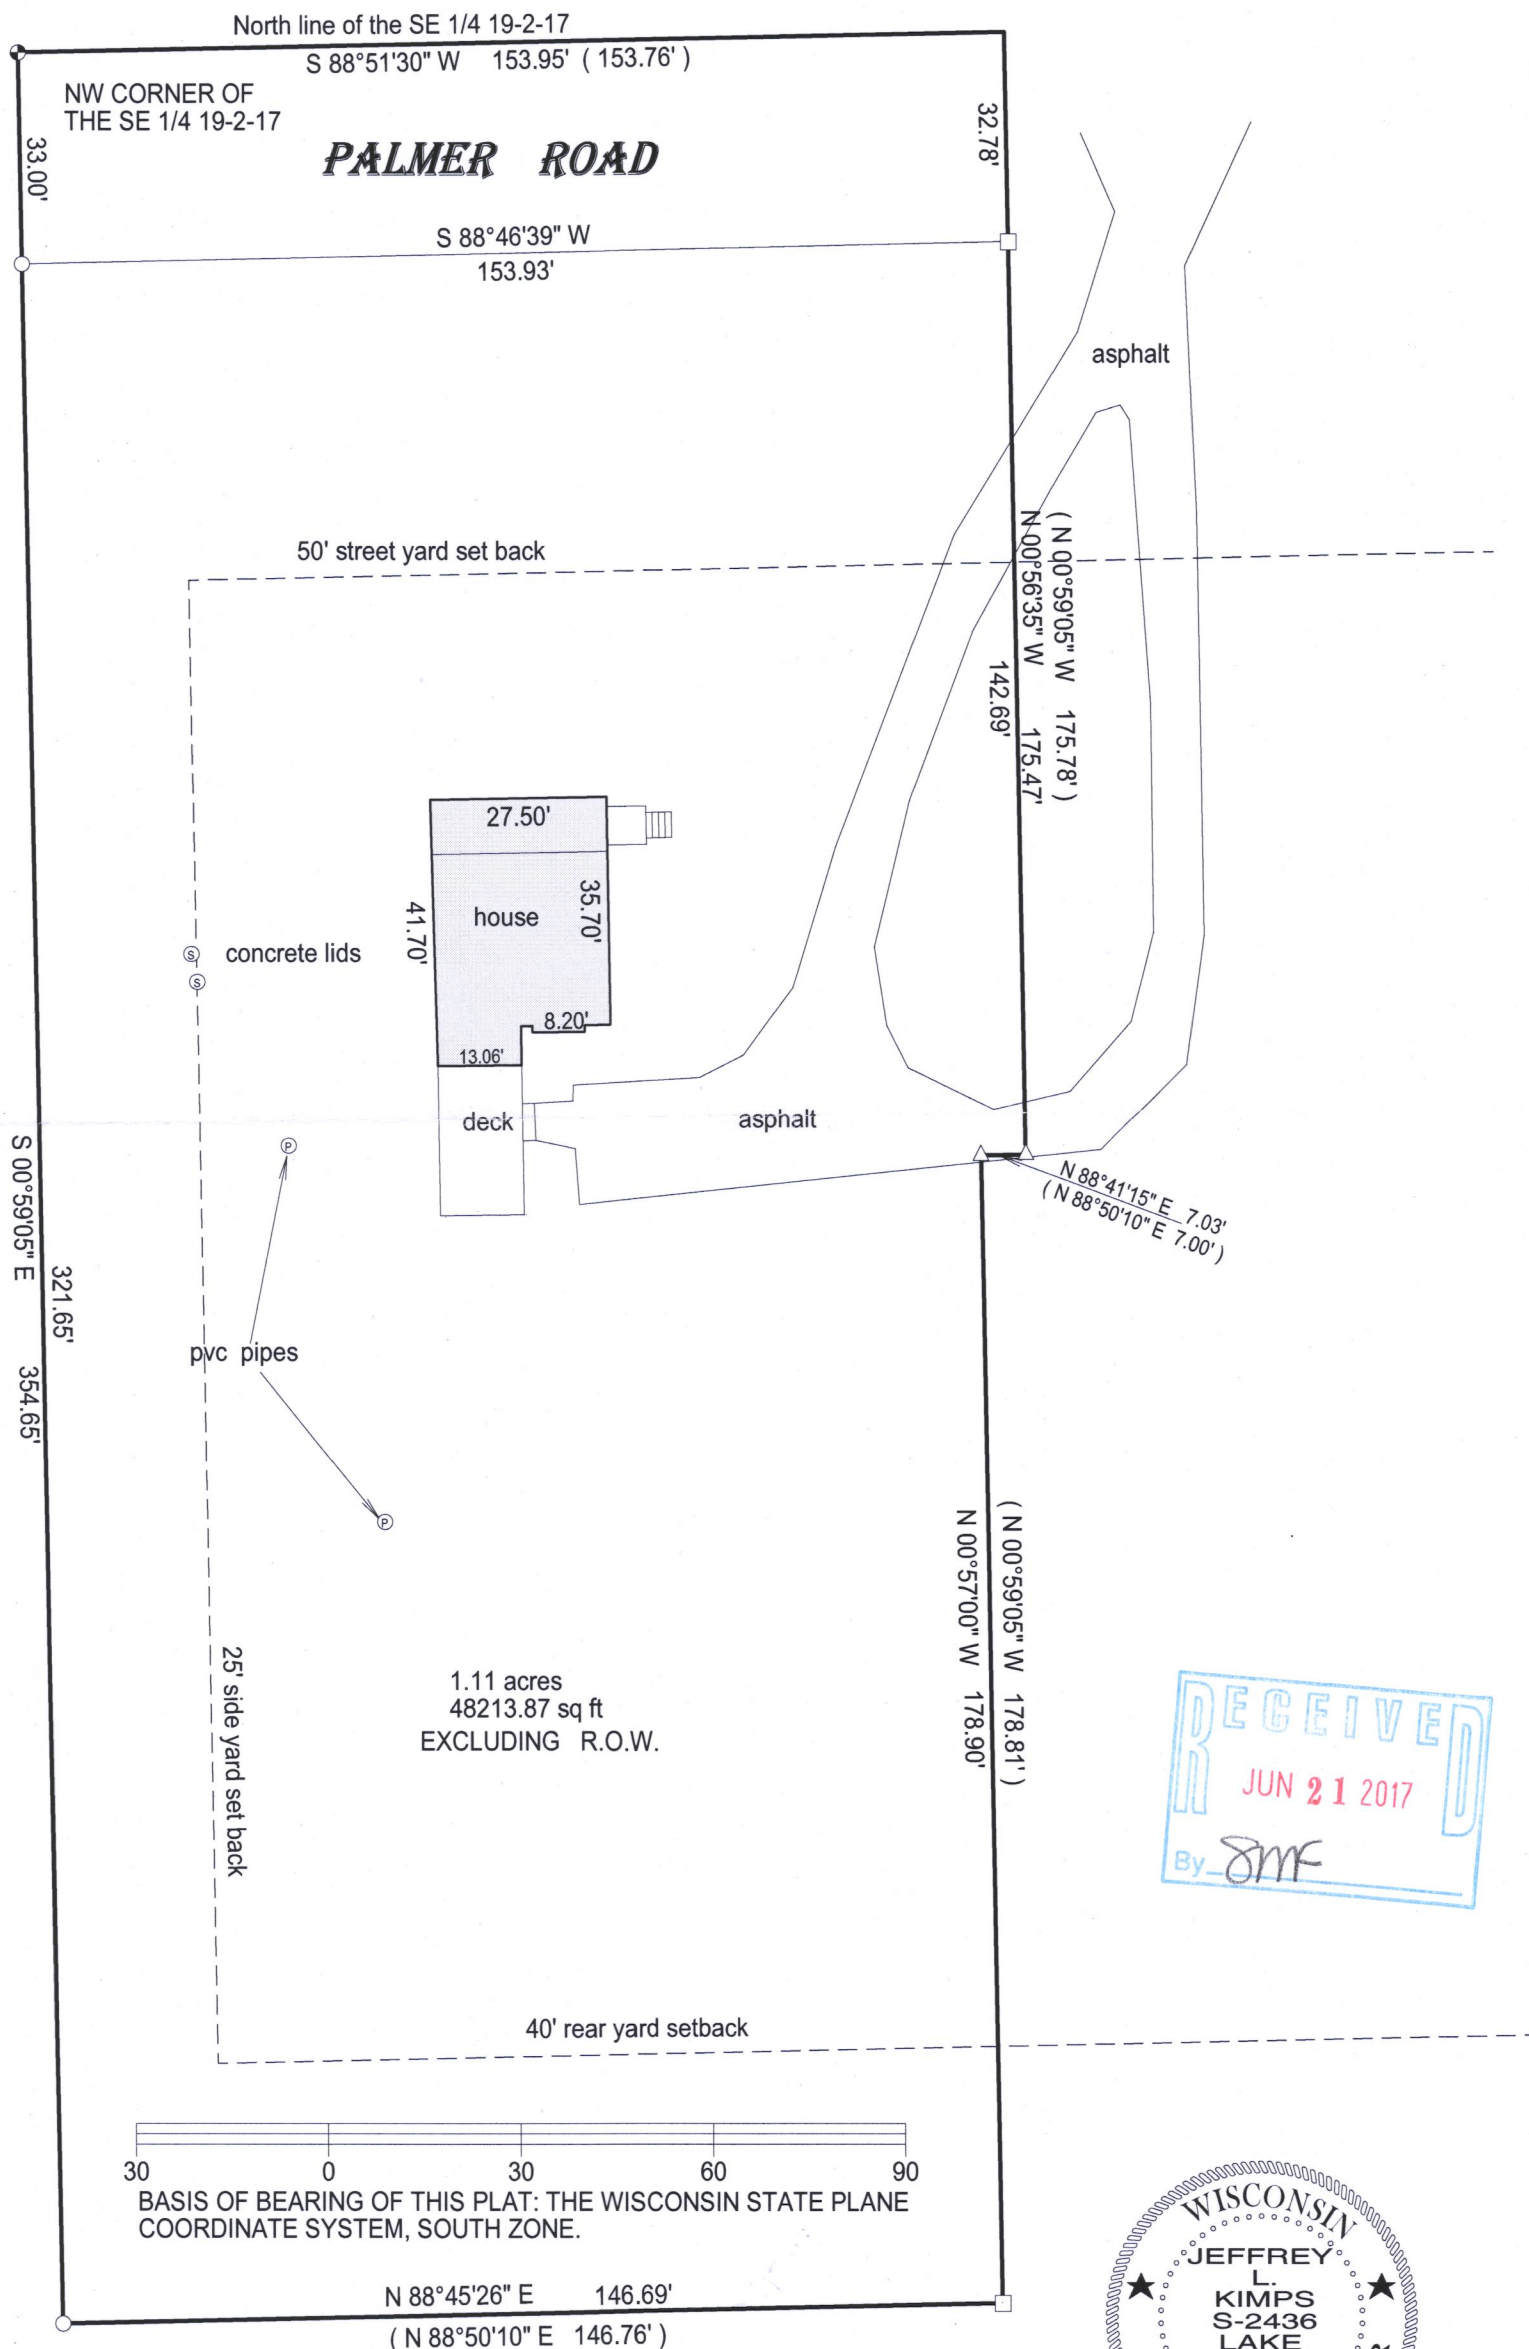

- () = recorded as
- = found iron bar
 - = found iron pipe
 - = set iron pipe
 - = set iron bar


SCALE 1" = 30'

JOB # 17-50

TAX ID # JGN5100003

I hereby certify that I have surveyed the above- described property and the above map is a true representation thereof and shows the size and location of the property, its exterior boundaries, the location and dimensions of all structures thereon, fences, apparant easements and roadways and visible encroachments if any.

This survey is made for the present owners of the property, and those who purchase, mortgage, or guarantee the title thereto, within one year from the date hereof. DATED THIS 17th day of March, 2017.

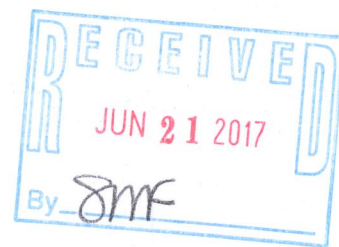

JEFFREY L KIMPS S - 2436
Wisconsin Professional Land Surveyor
(original if signed in red)

217-43171