## LAND-MARK SURVEYING

Mark L. Miritz Wisconsin Professional Land Surveyor S-2582

**N9330 Knuteson Drive** Whitewater, WI 53190 Phone:(262)495-3284 MarkMiritz@ Land-MarkSurveying.com


PLAT OF SURVEY

LEGAL DESCRIPTION

LOCATED IN THE SOUTHWEST 1/4, OF THE SOUTHWEST 1/4, SECTION 22, TOWNSHIP 2 NORTH, RANGE 17 EAST, IN THE TOWN OF GENEVA, WALWORTH COUNTY, WISCONSIN.

LOTS 2467 THRU 2476 (INCLUSIVE), BLOCK 44, OF LAKE COMO BEACH SECOND MAP.

OWNER: SUSAN L. MEISENHOLDER 199 W. NORTH AVE. WEST CHICAGO, IL. 60185

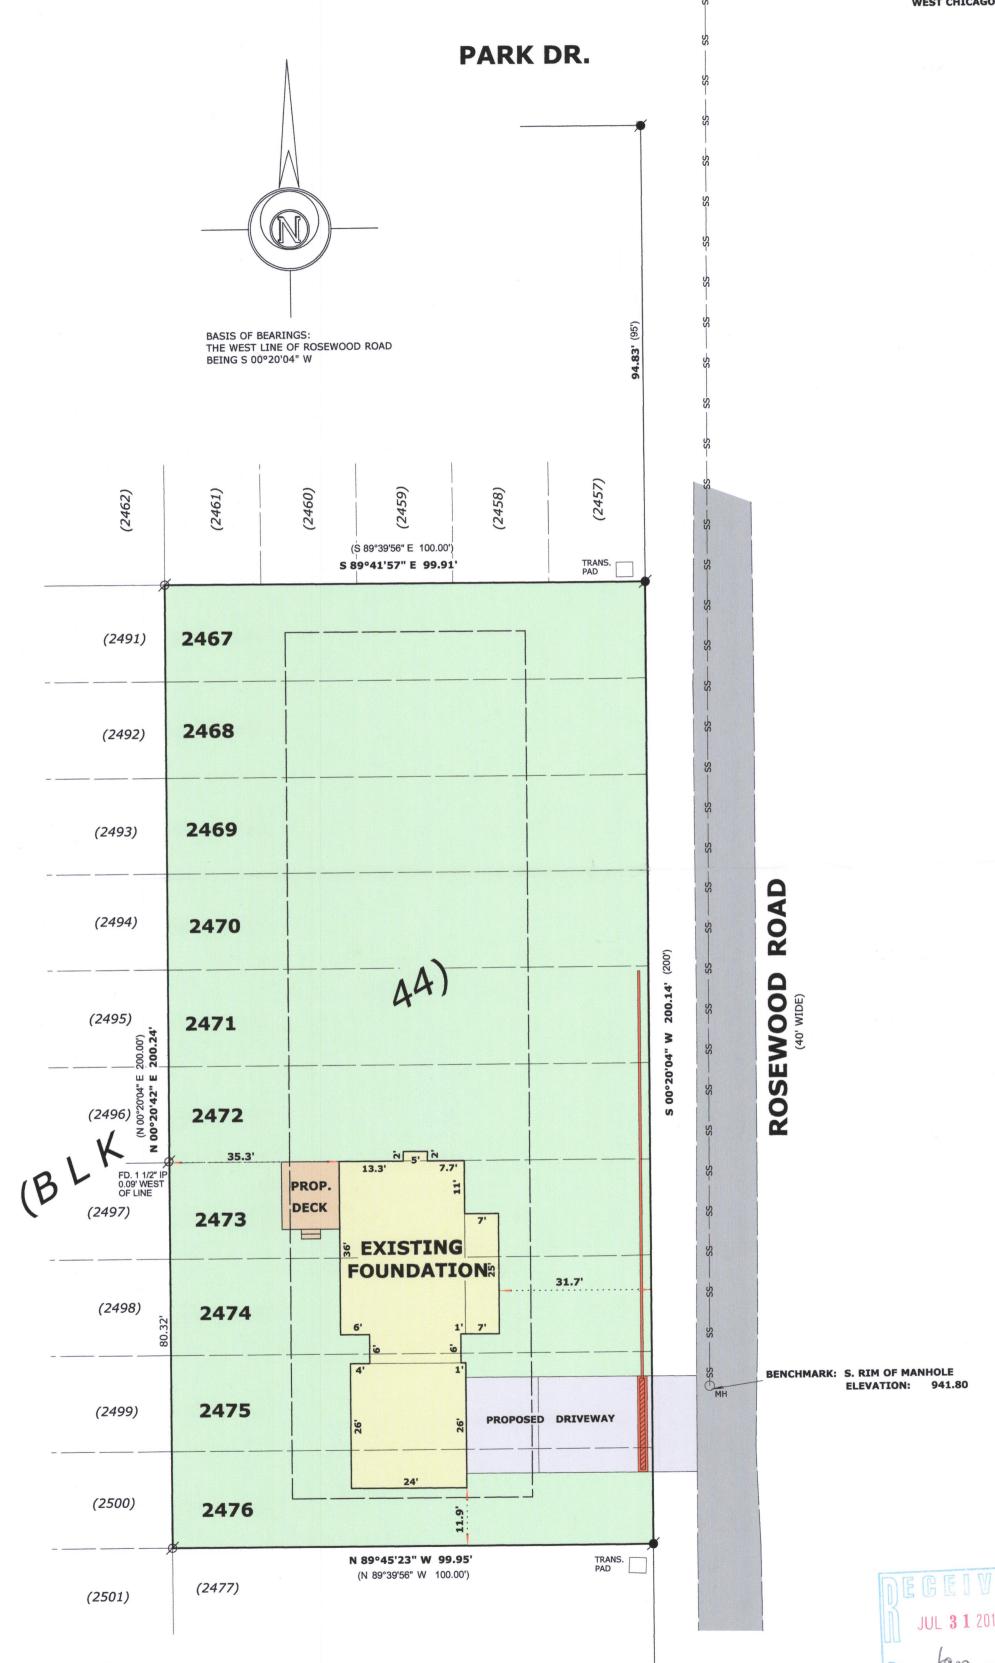

## **LEGEND**

FOUND IRON PIPE

**FOUND IRON ROD** RECORDED AS DIMENSION

## SCALE: 1 INCH = 20 FEET

"I hereby certify that the above described property has been surveyed by me or under my direction and that the above map is a true representation thereof and shows the size and location of the property, its exterior boundaries, the location of all visible structures and dimensions of all

principal buildings thereon, boundary fences, apparent easements, roadways and visible encroachments, if any."

"This survey is made for the use of the present owners of the property, and also those who purchase, mortgage, or guarantee the title thereto within one year from date

MARK L. MIRITZ **WISCONSIN PROFESSIONAL** 

**LAND SURVEYOR S-2582** 

JOB NO.\_\_17.404 DATE:\_\_\_\_April 4, 2017

JLCB-423

REVISED JULY 12, 2017 TO SHOW FOUNDATION "AS BUILT"

MARK L MIRITZ S-2582 WHITEWATER

217-4335