

PLAT OF SURVEY


LOT 1 OF CERTIFIED SURVEY MAP NO. 115, LOCATED
 IN THE NORTHWEST 1/4 OF SECTION 34, TOWN 2 NORTH,
 RANGE 17 EAST, GENEVA TOWNSHIP, WALWORTH
 COUNTY, WISCONSIN.

OWNER:
 BASSO BUILDERS INC.
 405 SKYLINE DR.
 LAKE GENEVA, WI 53147


LOT 13, WILDWOOD

LOT 14, WILDWOOD

COACHMAN'S TERRACE

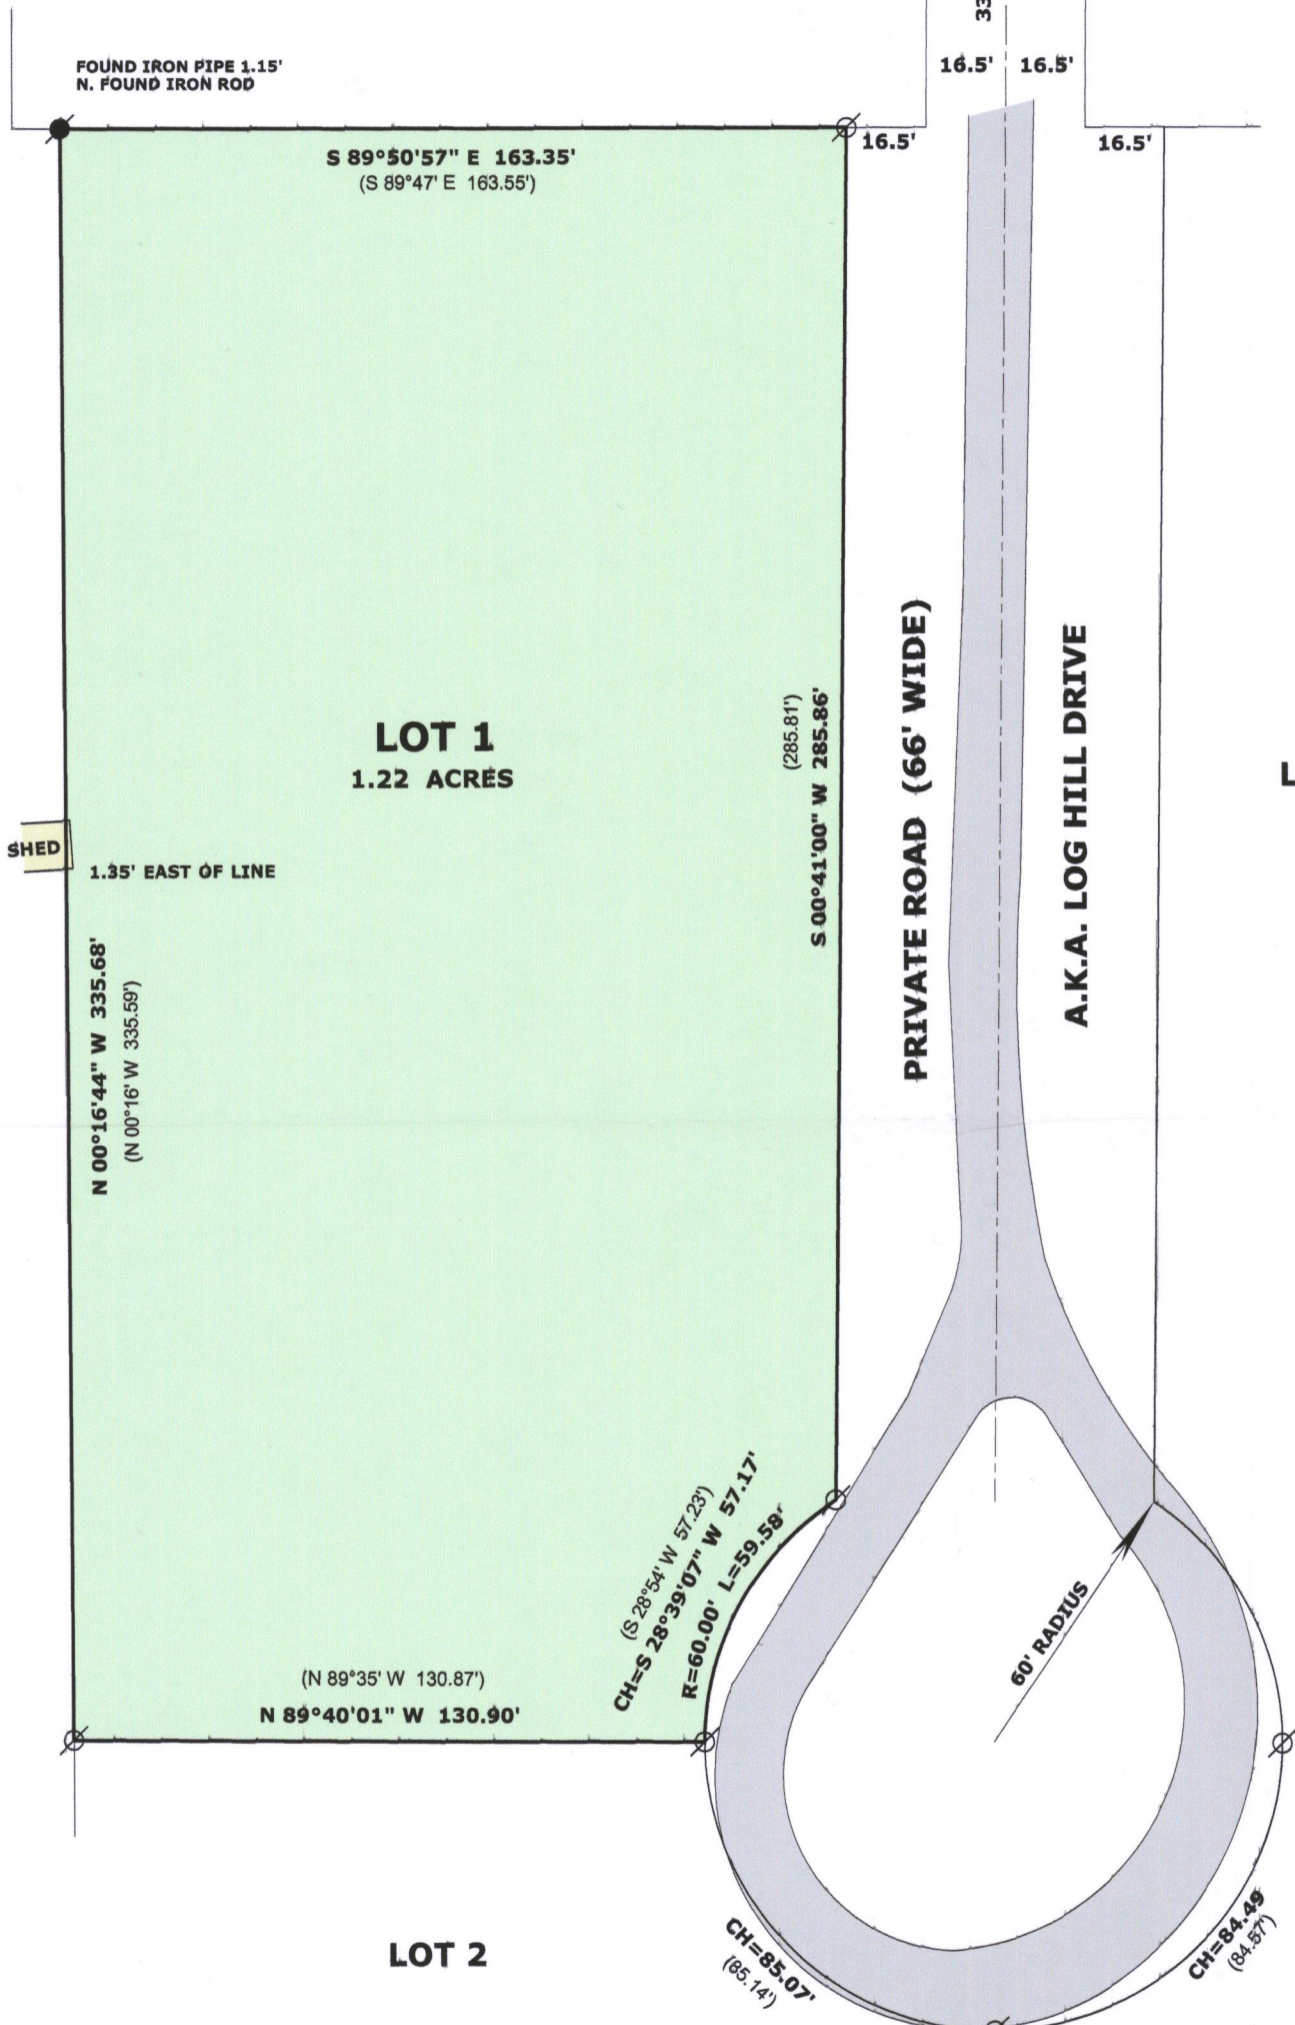

THE EAST LINE LOT 1 WAS
 ASSUMED S 00°41'00" W
 AS PLATTED

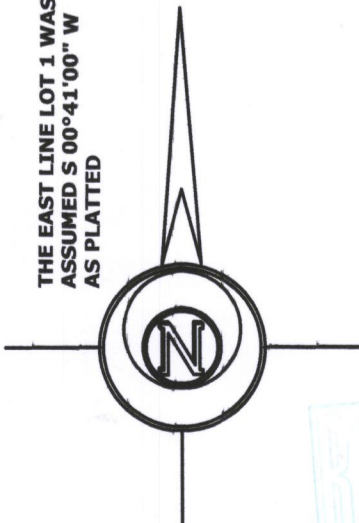

RECEIVED
 OCT 26 2017
 Jan



JA 115-1 217-4374

LEGEND

- FOUND IRON PIPE
- FOUND IRON ROD
- RECORDED AS DIMENSION

SCALE: 1 INCH = 40 FEET

"I hereby certify that the above described property has been surveyed by me or under my direction and that the above map is a true representation thereof and shows the size and location of the property, its exterior boundaries, the location of all visible structures and dimensions of all principal buildings thereon, boundary fences, apparent easements, roadways and visible encroachments, if any."
 "This survey is made for the use of the present owners of the property, and also those who purchase, mortgage, or guarantee the title thereto within one year from date hereof."

Mark L. Miritz
 MARK L. MIRITZ
 WISCONSIN PROFESSIONAL
 LAND SURVEYOR S-2582

DATE: SEPT. 25, 2017 JOB NO. 17.912