

Property Exhibit


of

Lot 1 of Certified Survey Map No. 4267,

recorded in Vol. 27 of Certified Survey Maps of Walworth County on Page 187 and located in the Northeast 1/4 of the Northeast 1/4 of Section 15 and the Northwest 1/4 of the Northwest 1/4 of Section 14, all in Town 2 North, Range 17 East, Town of Geneva, Walworth County, Wisconsin.

Surveyed for: **Jonathan & Jolene Singleton**

N4071 County Road NN
Elkhorn, Wisconsin, 53121

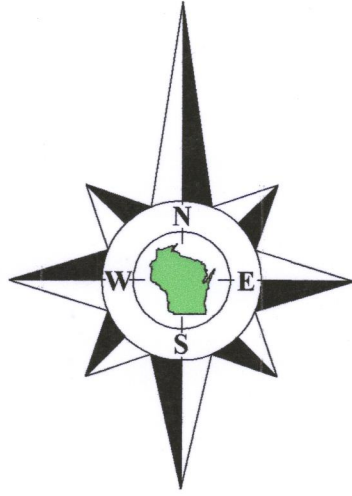


Bearings referenced to the East line of the Northeast 1/4 of Section 15-2-17, recorded as N1°07'16"W in the Wisconsin State Plane Coordinate System, South Zone, (NAD-27).

Tax Parcel
JG 1500001B

Lot 1
Tax Parcel
JA426700001
4.124 Acres
179,635 Sq.Ft.

Proposed
Movable
Shed

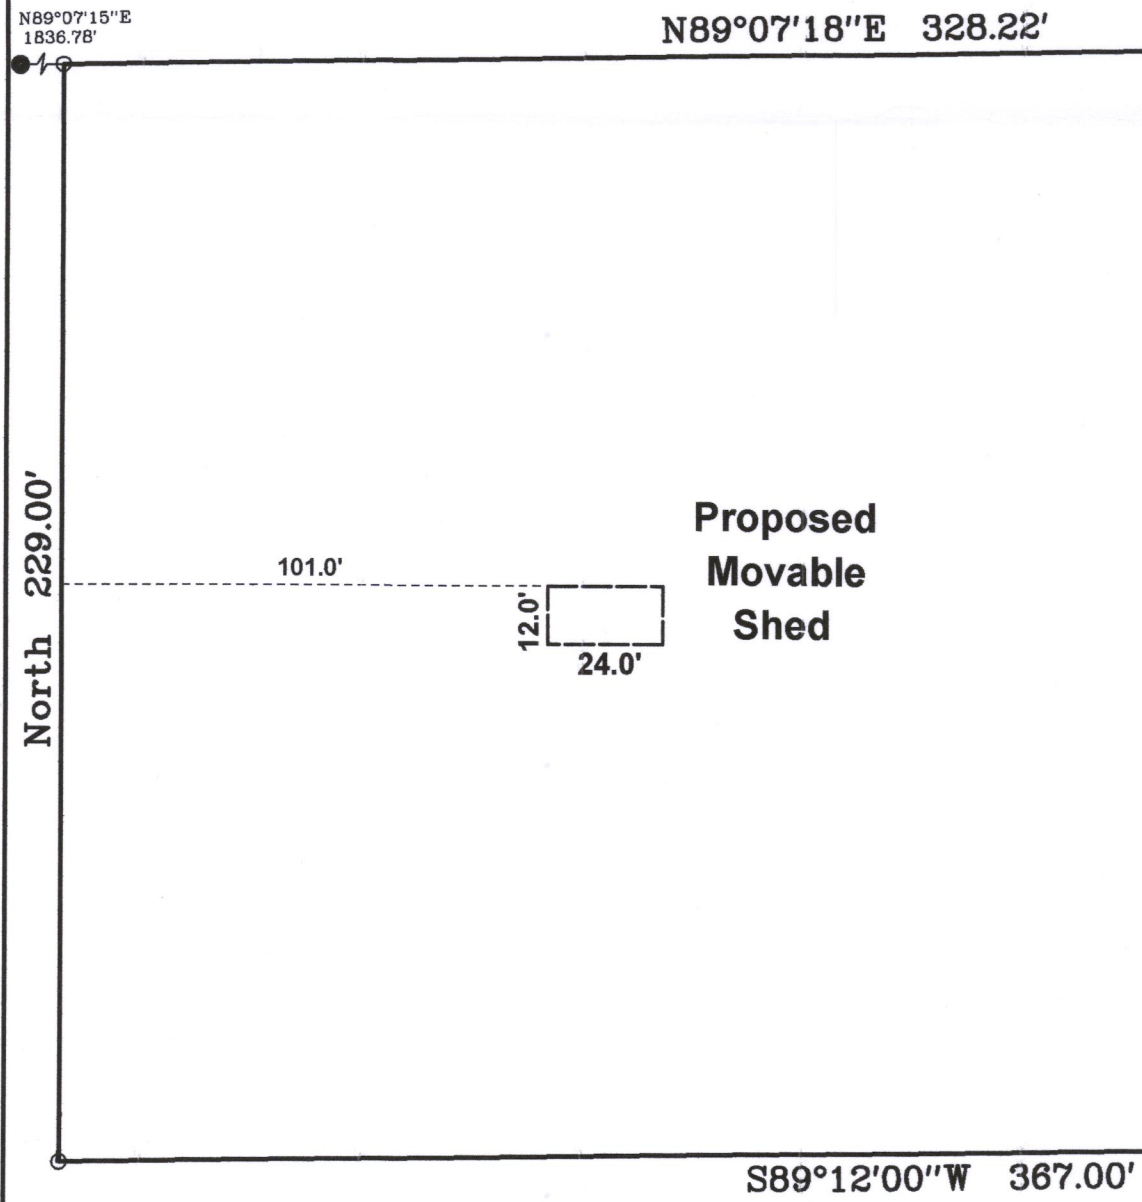


North 1/4 Corner Section 15-2-17. N. 237,268.84 E. 2,411,125.08
North line of the Northeast 1/4 of Section 15-2-17. S89°07'34"W 2623.38' (S89°07'34"W 2623.38') State Plane
Northeast Corner Section 15-2-17. N. 237,308.85 E. 2,413,748.08

Copyright 2008 by Jensen & Olson Land Surveying, LLC.
All rights reserved. No part of this property exhibit may be reproduced or transmitted in any form by any means - graphic, electronic, or mechanical, including photocopying, tracing, or information storage and retrieval systems - without permission in writing from Douglas G. Olson, Jensen & Olson Land Surveying, LLC.

I, Douglas G. Olson, Wisconsin Registered Land Surveyor, do hereby certify that this survey of a proposed rezone area was performed by me or under my direction in full compliance with the owner's / agent's instructions and that this map is an accurate representation thereof to the best of my knowledge and belief.

Note: This is not a complete "property survey" as defined in Chapter A-E 7 of the Wisconsin Administrative Code, "Minimum Standards for Property Surveys", and should not be relied on as such.

Douglas G. Olson
Wisconsin Registered Land Surveyor - 2093

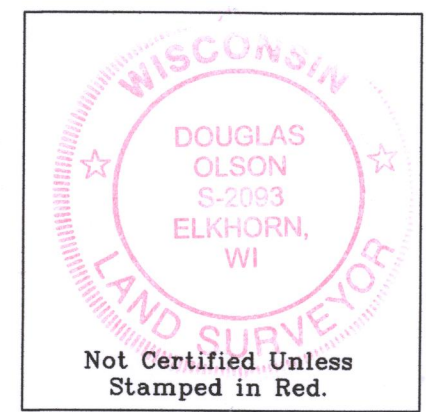


- Notes:
- 1) This property exhibit is not certified unless signed and sealed in red ink.
 - 2) This work is subject to Wisconsin lien laws. This Property Exhibit is the notice of intent to file lien. Lien waiver required.


JA4267-1

217-4323

Survey Date: July 11, 2008.
Revisions:
No. 1 - Prop. Easement
No. 2 - Staking
No. 3 - Proposed Shed & Building
No. 4 - As-built Building

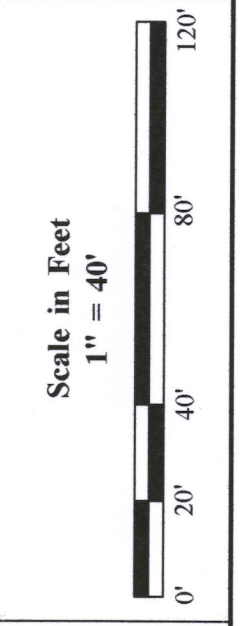

45 South Wisconsin Street | P.O. Box 322
Elkhorn, Wisconsin, 53121
Telephone: (262) 723-3434
Facsimile: (262) 723-8044
Email: doug@olsonsurveying.com
Website: www.olsonsurveying.com

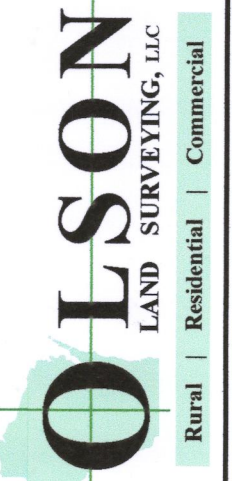

- Legend of Symbols & Abbreviations
- Found County Section Corner
 - Set Wood Lath
 - Found Iron Pipe
 - Set 02-13-17
 - Found Iron Rod
 - Gravel
 - Recorded Information
 - 3/4" dia. Utility Pole
 - Asphalt Surface
 - Concrete Surface

Sheet 1 of 1 Sheets
Drawing Name:
Job Reference Number
2017.005

2017.005