PREPARED FOR SUNRISE HOMES, INC.

> ORDERED BY STEVE BERGHOLTZ


PLAT OF SURVEY

- OF -

LOT 6 OF MAPLE TREE FARMS A SUBDIVISION OF PART OF THE NORTHWEST 1/4, SOUTHWEST 1/4 AND SOUTHEAST 1/4 OF THE SOUTHEAST 1/4 OF SECTION 33, TOWNSHIP 2 NORTH, RANGE 17 EAST, TOWN OF GENEVA, COUNTY OF WALWORTH AND STATE OF WISCONSIN.

PATHFINDER SURVEYING (a NMB Company) P.O BOX 322 LAKE GENEVA, WI. 53147 WWW.PATHFINDERSURVEYING.NET 262-248-8303

P

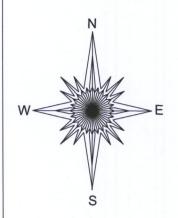

FOUNDATION CERTIFICATION The foundation of the residence depicted hereon has been constructed as located. Top of Foundation = 1043.59. All other elevations are from survey January 29, 2018

March 26, 2018

PROPERTY ADDRESS: _____ Maple Tree Lane

N 24°21'49" E 146.68 A=151.52 R=172.27

332.

ш

00.20,00

S

20

PEDESTRIAN

图


BACK 040 91.02

PROPOSED AS BUILT

1040.

1041-

Proposed Top of Foundation 1042.17 Proposed Finished Garage Floor 1041.83 Proposed Finished Yard Grade 1041.50

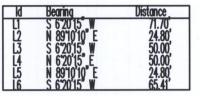

PROPOSED 15" CMP

otag

BENCHMARK "PK" NAIL EDGE OF PAVEMENT ELEV. 1036.41

N 72°56'56" E

R=66.00

6 -1039 1 25'

> 8 4

S 8910'10" W 440.23

LO7

25' SET BACK

3

() = recorded as

= electric pedestal

= found iron pipe

= pad mount transformer

= communication box

= hydrant


= set 5/8" rebar

= set "PK" nail

SCALE 1" = 60'

JOB # 2017.0259.01

TAX ID # JMAP 00006

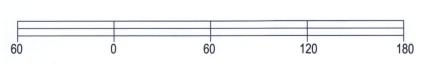

BASIS OF BEARING OF THIS PLAT: THE US STATE PLANE COORDINATE SYSTEM SOUTH ZONE, NAD 83. WISCORS.


-1039

I hereby certify that I have surveyed the above- described property and the above map is a is a true representation thereof and shows the size and location of the property, its exterior boundaries, the location and dimensions of all structures thereon, fences, apparent easements and roadways and visible encroachments if any.

This survey is made for the present owners of the property, and those who purchase, mortgage, or guarantee the title thereto, within one year from the date hereof.

DATED THIS 29TH DAY OF JANUARY, 2018.



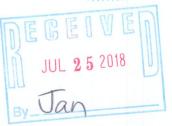

MARK R. MADSEN S - 2271

Wisconsin Professional Land Surveyor