


PLAT OF SURVEY

LOT 19, WILDWOOD SUBDIVISION, LOCATED IN
SECTION 34, TOWN 2 NORTH, RANGE 17 EAST,
TOWN OF GENEVA, WALWORTH COUNTY, WISCONSIN.

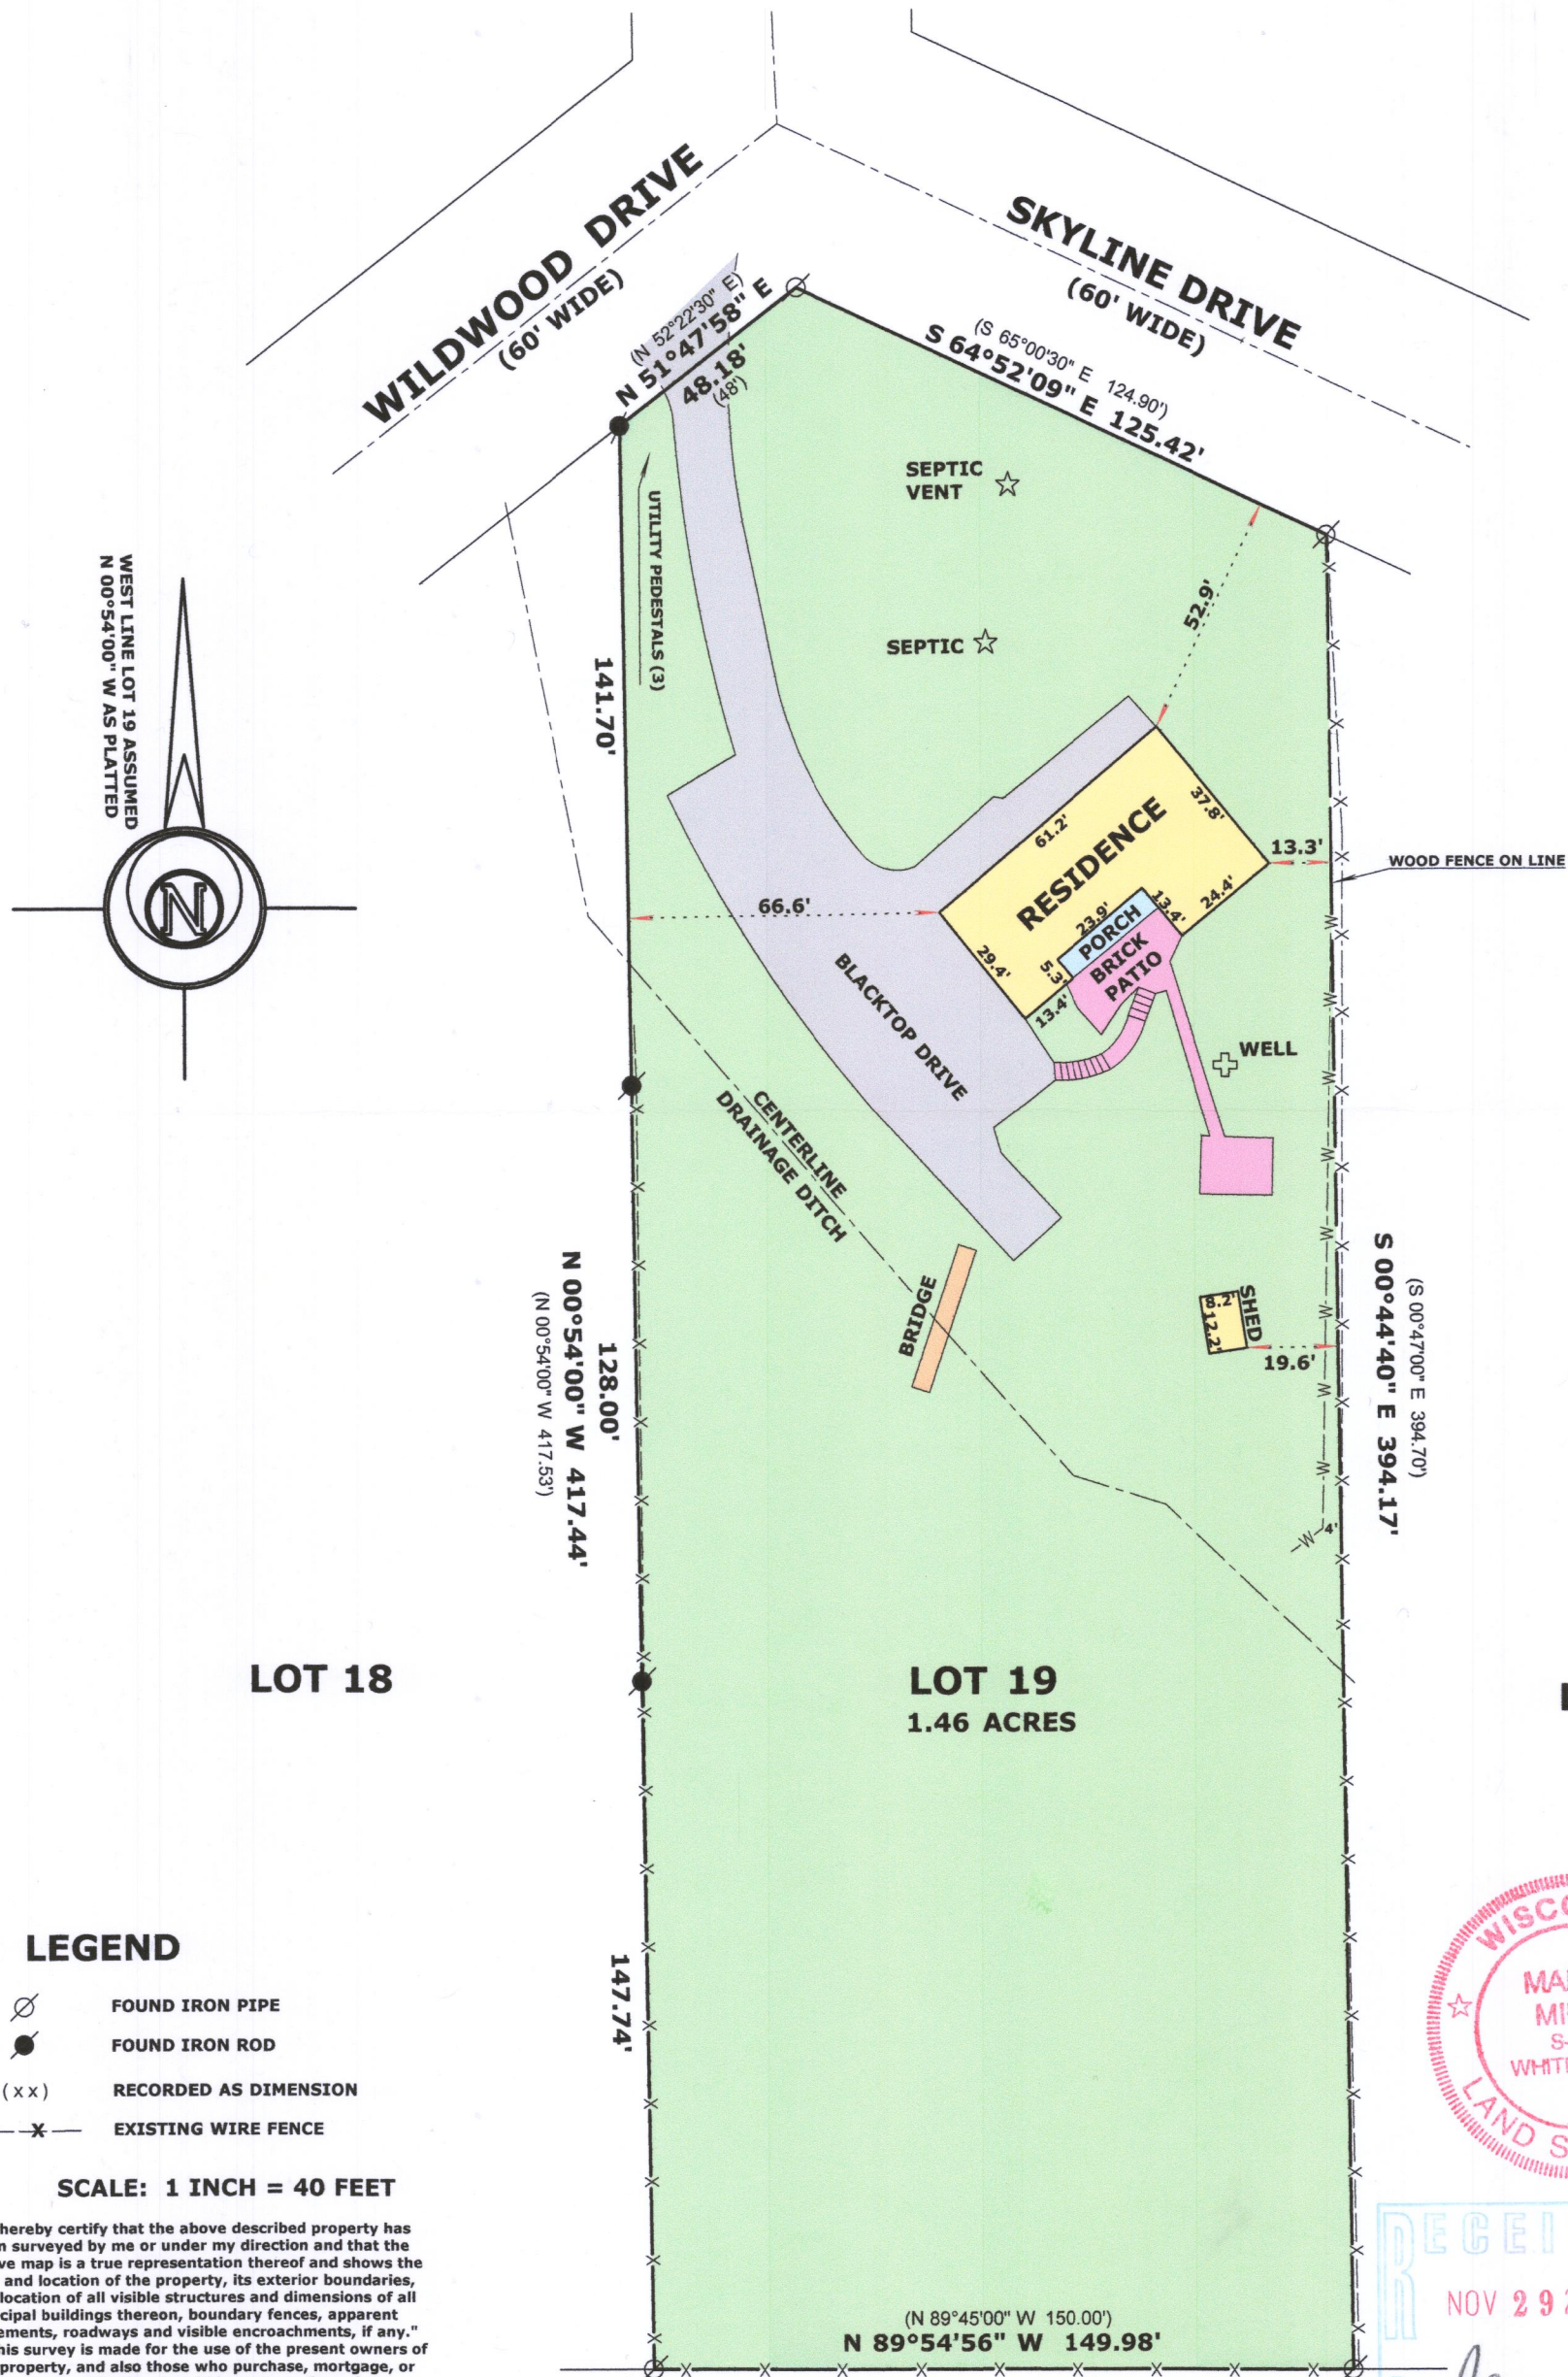

Mark L. Miritz
MARK L. MIRITZ
WISCONSIN PROFESSIONAL
LAND SURVEYOR S-2582