


PLAT OF SURVEY

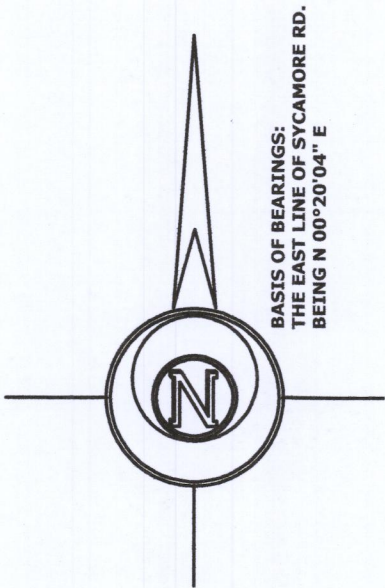

LEGAL DESCRIPTION

LOTS 2497 THRU 2502 INCLUSIVE,
IN BLOCK 44, LAKE COMO BEACH
SECOND MAP

LOCATED IN THE SOUTHWEST 1/4
OF THE SOUTHWEST 1/4, SECTION
22, TOWNSHIP 2 NORTH, RANGE 17
EAST, IN THE TOWN OF GENEVA,
WALWORTH COUNTY, WISCONSIN

LEGAL DESCRIPTION

LOTS 2503 THRU 2508 INCLUSIVE,
IN BLOCK 44, LAKE COMO BEACH
SECOND MAP

LOCATED IN THE SOUTHWEST 1/4
OF THE SOUTHWEST 1/4, SECTION
22, TOWNSHIP 2 NORTH, RANGE 17
EAST, IN THE TOWN OF GENEVA,
WALWORTH COUNTY, WISCONSIN

LEGAL DESCRIPTION

LOTS 2509 THRU 2514 INCLUSIVE,
IN BLOCK 44, LAKE COMO BEACH
SECOND MAP

LOCATED IN THE SOUTHWEST 1/4
OF THE SOUTHWEST 1/4, SECTION
22, TOWNSHIP 2 NORTH, RANGE 17
EAST, IN THE TOWN OF GENEVA,
WALWORTH COUNTY, WISCONSIN

LEGEND


- FOUND IRON PIPE
- FOUND IRON ROD
- RECORDED AS DIMENSION

SCALE: 1 INCH = 30 FEET

"I hereby certify that the above described property has been surveyed by me or under my direction and that the above map is a true representation thereof and shows the size and location of the property, its exterior boundaries, the location of all visible structures and dimensions of all principal buildings thereon, boundary fences, apparent easements, roadways and visible encroachments, if any."
"This survey is made for the use of the present owners of the property, and also those who purchase, mortgage, or guarantee the title thereto within one year from date hereof."

Mark L. Miritz
MARK L. MIRITZ
WISCONSIN PROFESSIONAL
LAND SURVEYOR S-2582

DATE: AUGUST 14, 2017 JOB NO. 17.808

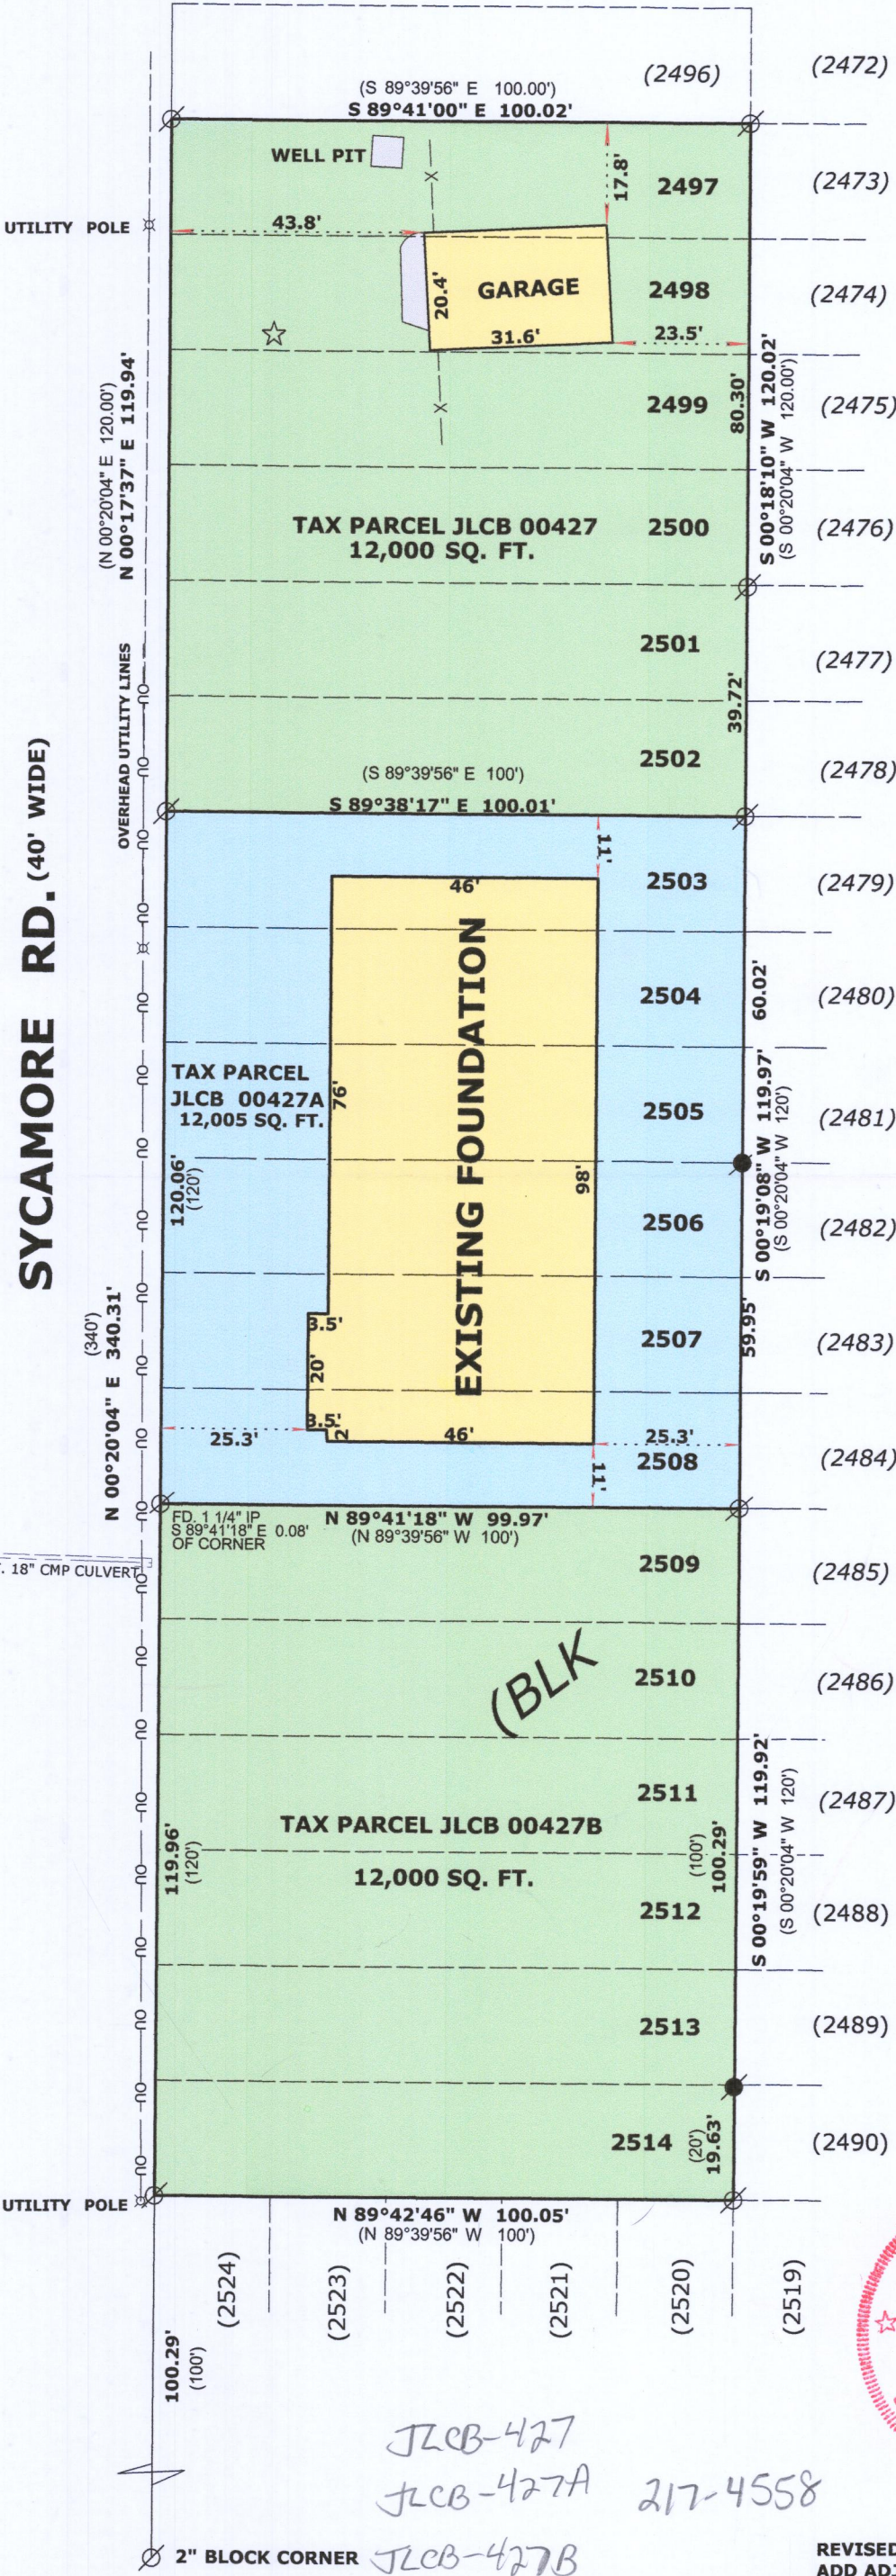

REVISED JUNE 23, 2019 TO
ADD ADJACENT TAX KEYS