

LAND-MARK SURVEYING

Mark L. Miritz



Wisconsin Professional Land Surveyor S-2582

N9330 Knuteson Drive  
Whitewater, WI 53190  
Phone: (262) 495-3284  
MARKMIRITZ@  
LAND-MARKSURVEYING.COM

PLAT OF SURVEY

ORDERED BY:  
RACHEL SCHINKE  
RAULAND AGENCY  
118 KENOSHA ST.  
WALWORTH, WI 53184

LOT 1 OF CERTIFIED SURVEY MAP NO. 2236, LOCATED IN  
THE SOUTHEAST 1/4 OF THE NORTHEAST 1/4 AND THE  
NORTHEAST 1/4 OF THE SOUTHEAST 1/4 OF SECTION 34,  
TOWN 2 NORTH, RANGE 17 EAST, TOWN OF GENEVA,  
WALWORTH COUNTY, WISCONSIN.

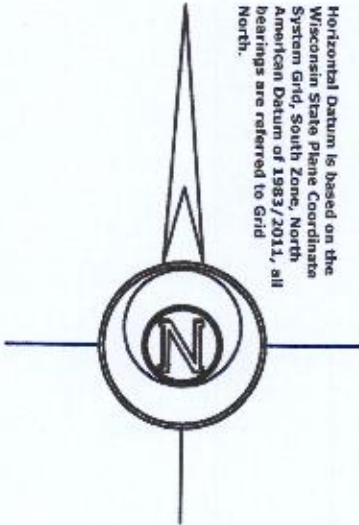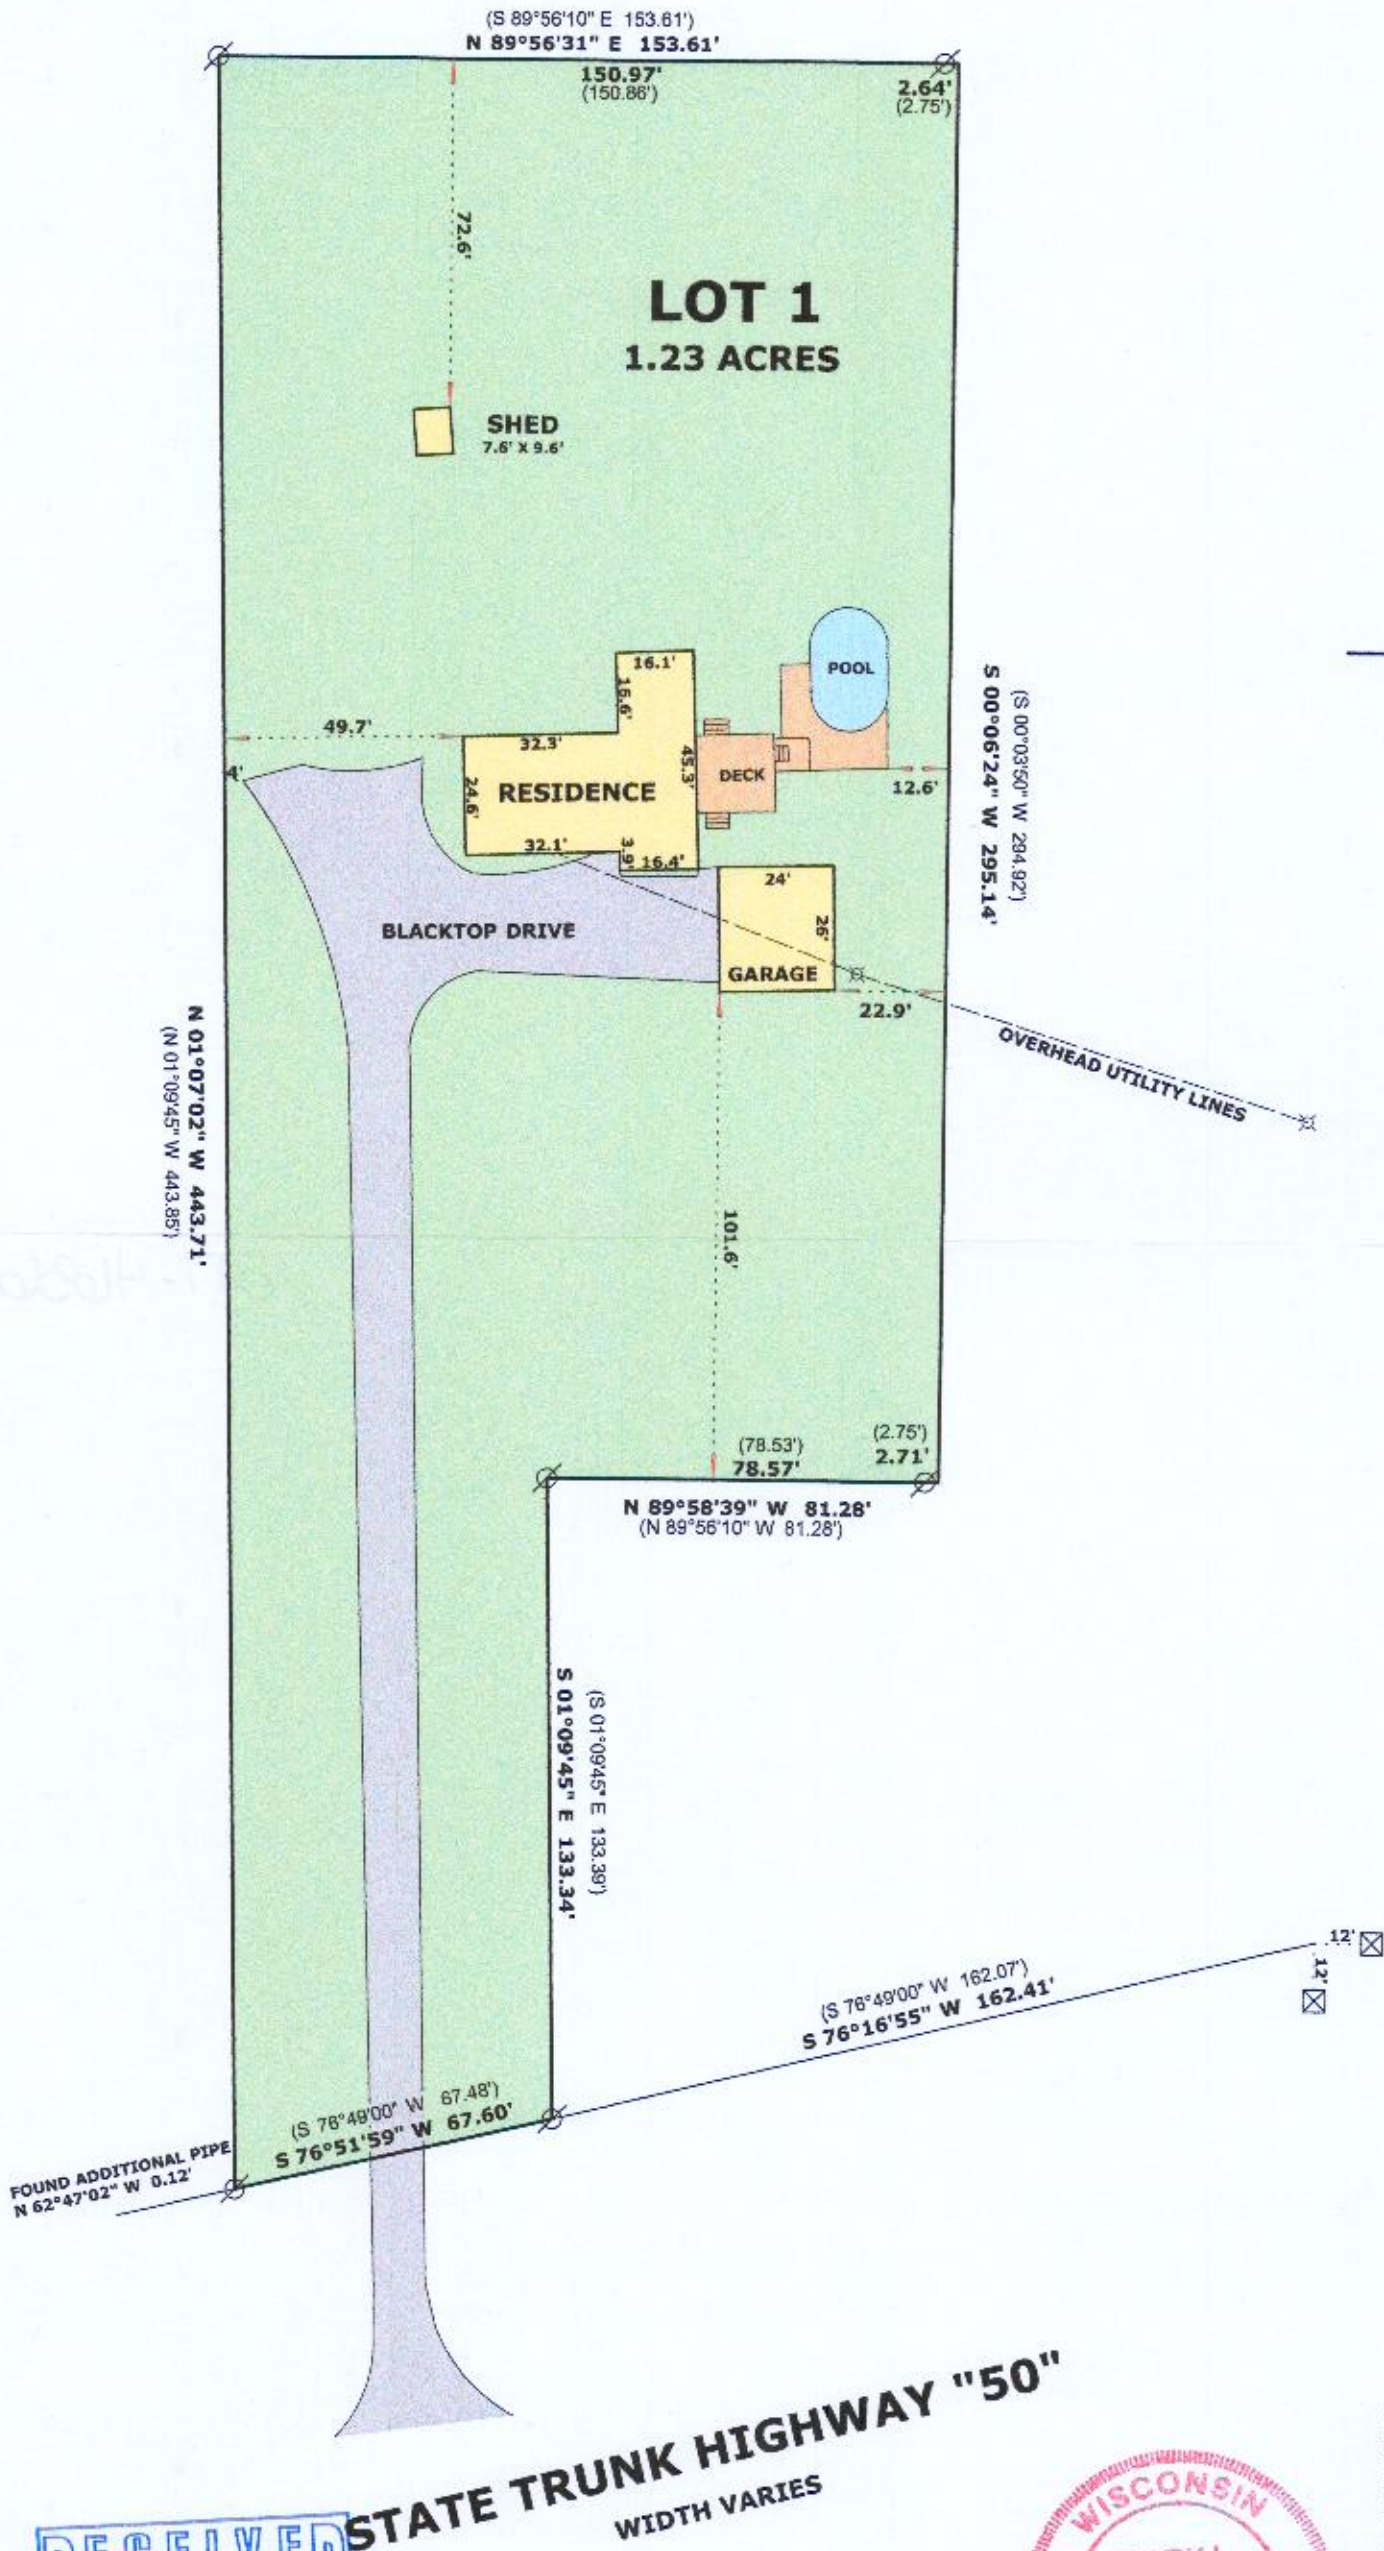

RECEIVED  
APR 28 2020  
By *SMF*



*Mark L. Miritz*  
MARK L. MIRITZ  
WISCONSIN PROFESSIONAL  
LAND SURVEYOR S-2582

DATE: JAN. 11, 2020 JOB NO. 20.103

JA2236-1

217-4636