
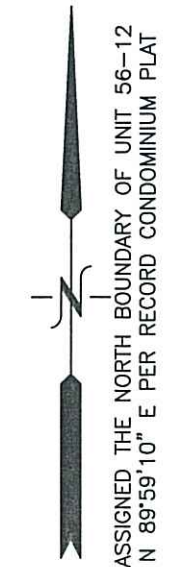


# PLAT OF SURVEY UNIT 56-12 OF GENEVA NATIONAL CONDOMINIUM NO. 56

LOCATED IN PART OF THE SW 1/4 OF THE NE 1/4 OF SECTION 31, TOWN 2 NORTH,  
RANGE 17 EAST, WALWORTH COUNTY, WISCONSIN

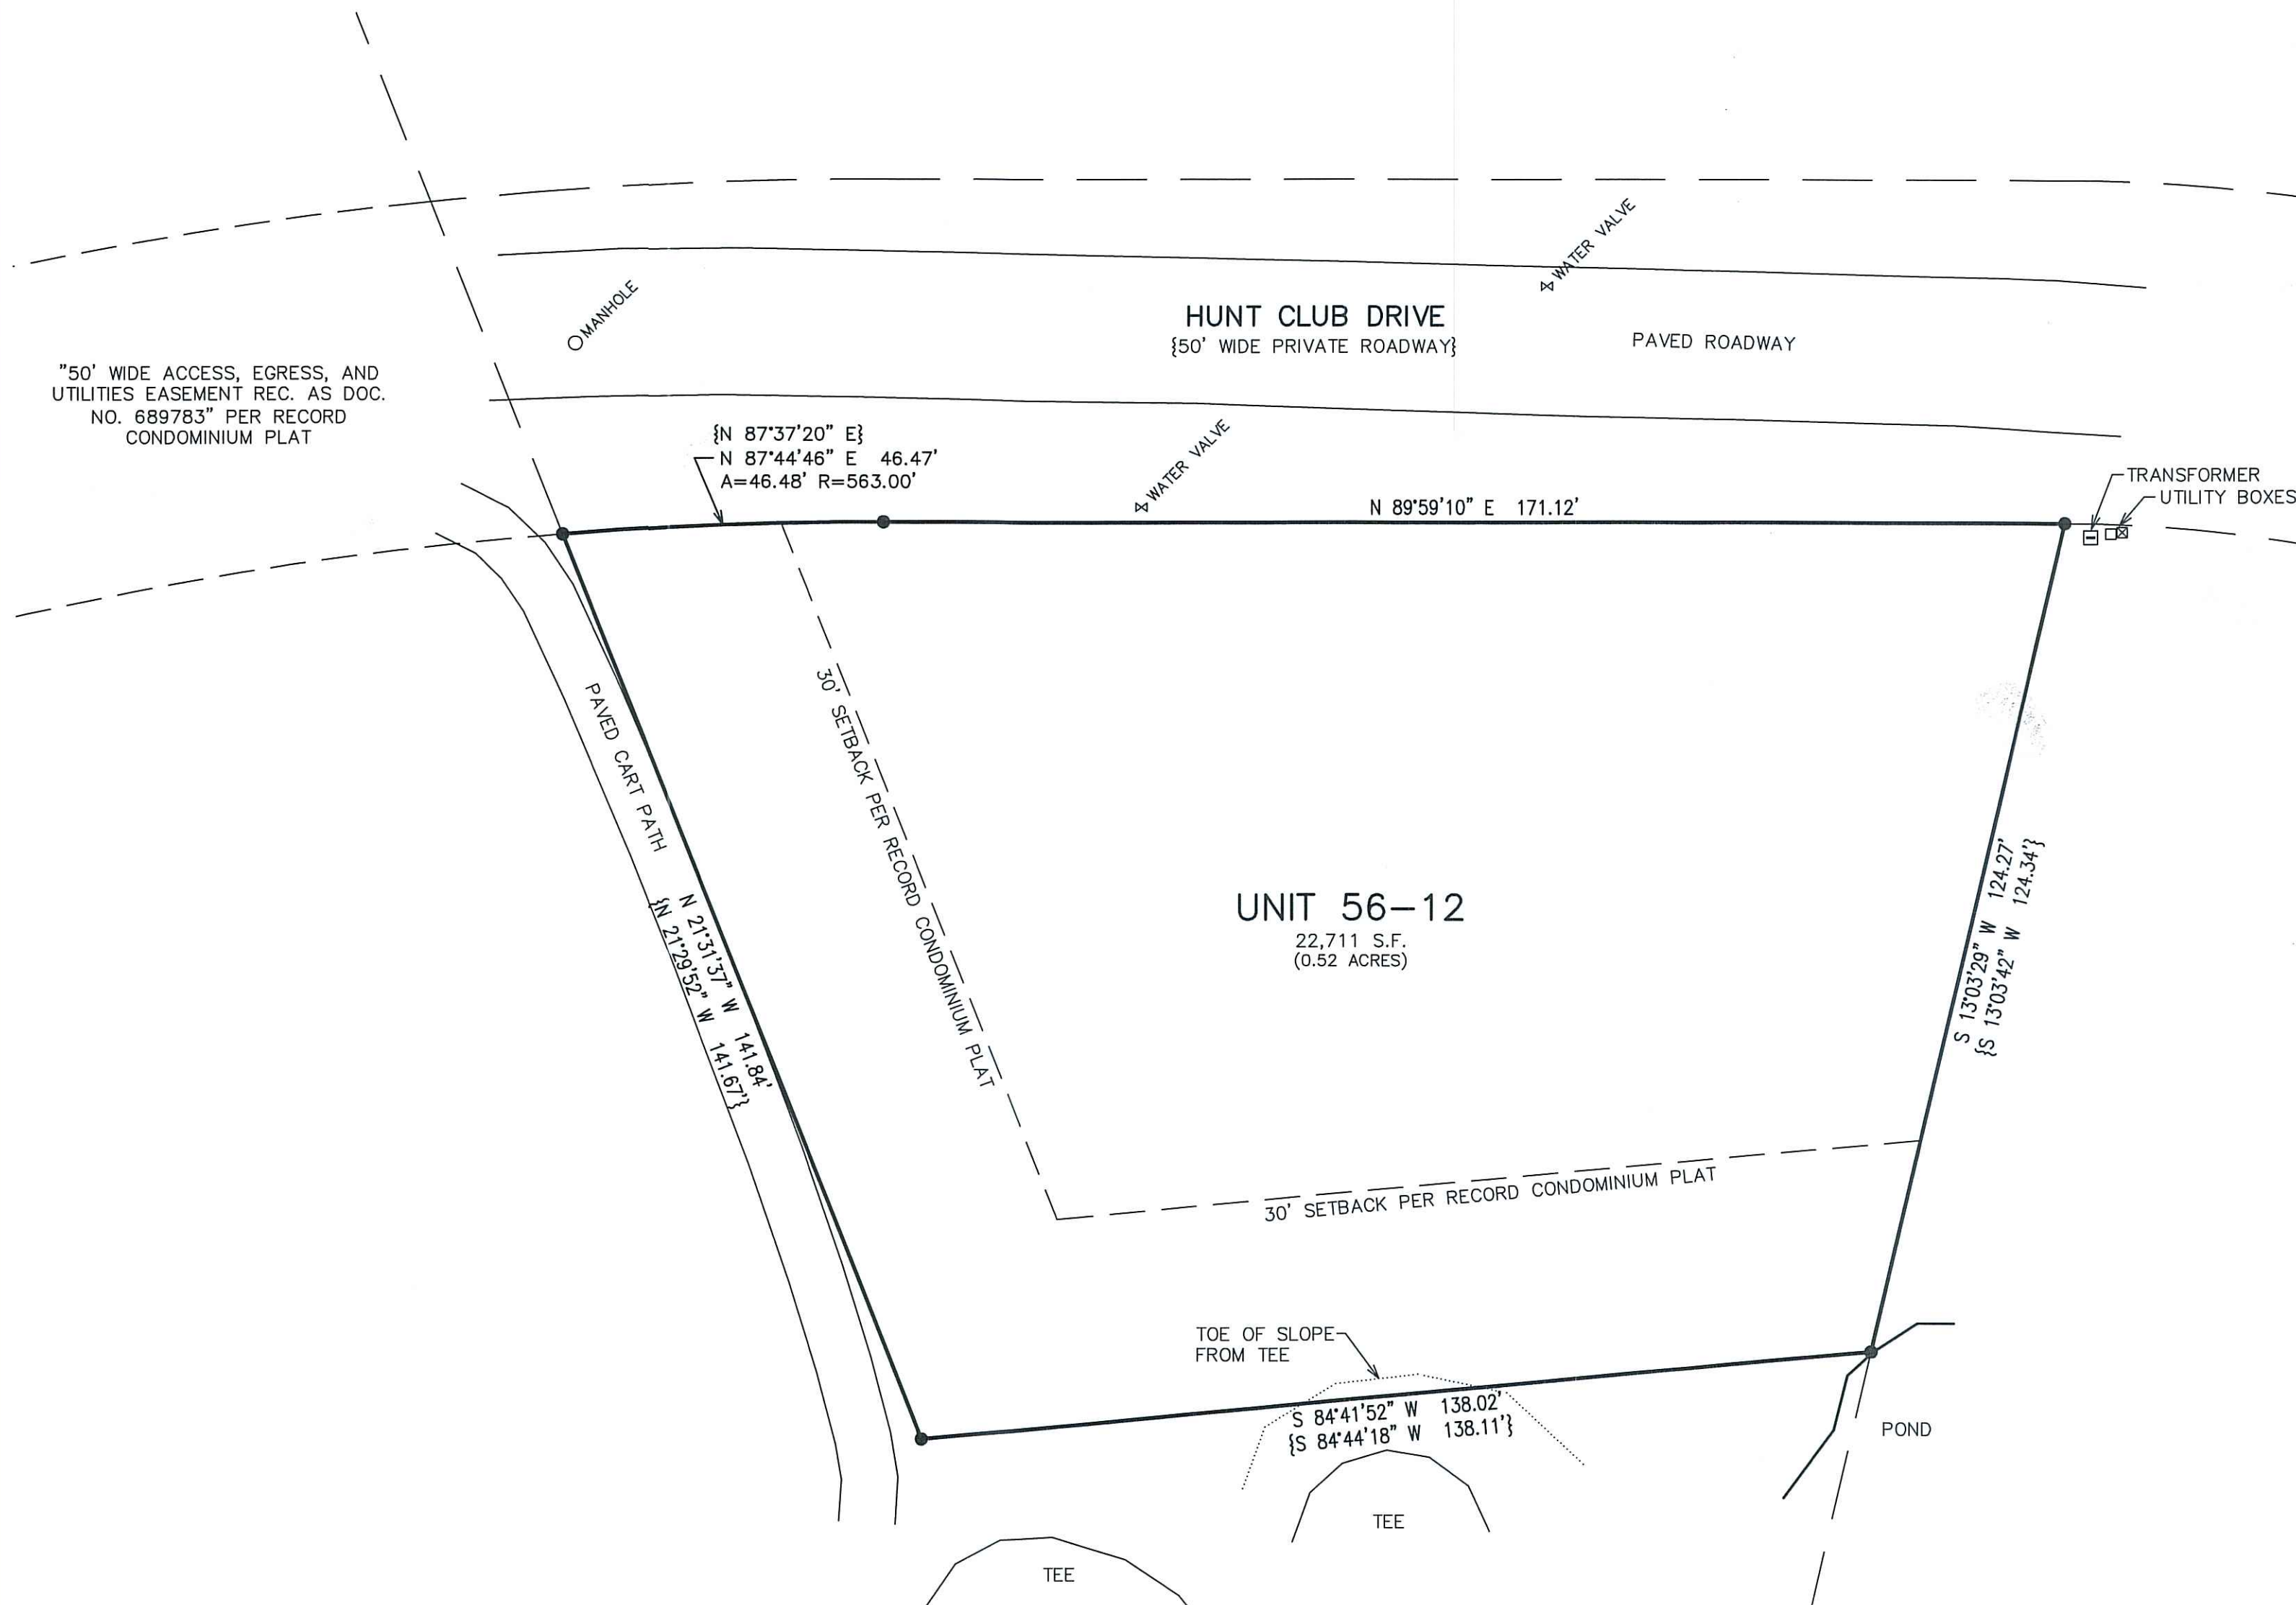


LEGEND  
● = FOUND IRON REBAR STAKE  
{XXX} = RECORDED AS

NOTE: COPIES OF THIS MAP TO WHICH THE FOLLOWING CERTIFICATE WILL APPLY SHOW THE SURVEYOR'S ORIGINAL SEAL AND SIGNATURE IN RED INK. COPIES BY ANY OTHER MEANS MAY HAVE ALTERATIONS WHICH DO NOT REPRESENT THE SURVEYOR'S WORK PRODUCT.

I HEREBY CERTIFY THAT THE ABOVE DESCRIBED PROPERTY HAS BEEN SURVEYED UNDER MY DIRECTION AND THAT THE ABOVE MAP IS A TRUE REPRESENTATION THEREOF AND SHOWS THE SIZE AND LOCATION OF THE PROPERTY AND ITS EXTERIOR BOUNDARIES. THIS SURVEY IS MADE FOR THE USE OF THE PRESENT OWNERS OF THE PROPERTY, AND ALSO THOSE WHO PURCHASE, MORTGAGE, OR GUARANTEE THE TITLE THERETO WITHIN ONE YEAR FROM THE DATE HEREOF.

DATED: 3/22/2021

*Christopher A. Hodges*  
CHRISTOPHER A. HODGES P.L.S. 2760

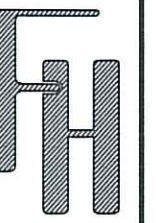

PLAT OF SURVEY  
TOWN OF GENEVA  
WALWORTH COUNTY, WISCONSIN

WORK ORDERED BY -  
LOWELL MANAGEMENT, INC.  
P.O. BOX 926 GENEVA NATIONAL  
LAKE GENEVA, WI 53147

FARRIS, HANSEN & ASSOCIATES, INC.  
ENGINEERING - ARCHITECTURE - SURVEYING  
7 RIDGWAY COURT P.O. BOX 437  
ELKHORN, WISCONSIN 53121  
OFFICE: (262) 723-2098 FAX: (262) 723-5886

REVISIONS

PROJECT NO.  
3269.56.12  
DATE:  
03/22/2021  
SHEET NO.  
1 OF 1

X:\PROJECTS\3269\CONDO\_56\INDVLOTS\UNIT\_12\ACAD\3269\_56\_12.dwg