


FOUNDATION AS-BUILT

A PARCEL OF LAND LOCATED IN THE SOUTHEAST 1/4 OF THE SOUTHEAST 1/4 OF SECTION 3 IN TOWNSHIP 2 NORTH, RANGE 17 EAST, IN THE TOWN OF GENEVA, WALWORTH COUNTY, WISCONSIN.

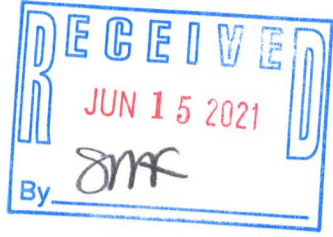

NOTE:

1. BASIS OF BEARING: THE WISCONSIN STATE PLANE COORDINATE SYSTEM, NAD83 ILLINOIS STATE PLANE, EAST ZONE.
2. FIELD WORK COMPLETED MAY 12, 2021
3. FIELD CREW CHIEF: LUKE COFFEY



LEGAL DESCRIPTION

A PARCEL OF LAND LOCATED IN THE SOUTHEAST 1/4 OF THE SOUTHEAST 1/4 OF SECTION 3 IN TOWNSHIP 2 NORTH, RANGE 17 EAST, IN THE TOWN OF GENEVA, WALWORTH COUNTY, WISCONSIN, MORE PARTICULARLY DESCRIBED AS:

LOT 1 OF CSM 4135 AS RECORDED IN DOCUMENT 734220 AS PER THE WALWORTH COUNTY REGISTER OF DEEDS. ALSO; COMMENCING AT THE NORTHWEST CORNER OF LOT 1 OF CSM 4135 THENCE N89°32'13"W 50.00'; THENCE S08°03'29"W 332.24'; THENCE S81°59'15"E 50.00'; THENCE N07°59'02"E 338.81 RETURNING TO THE POINT OF BEGINNING.

LEGEND

- FOUND 1" IRON PIPE
- ▨ NEW CONCRETE
- ⊕ UTILITY POLE

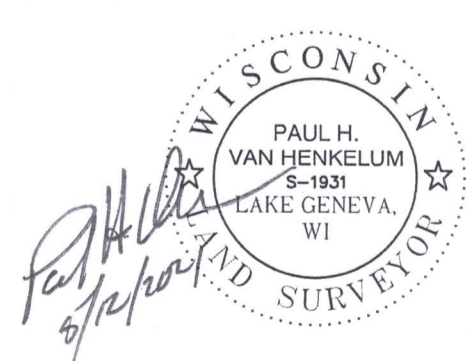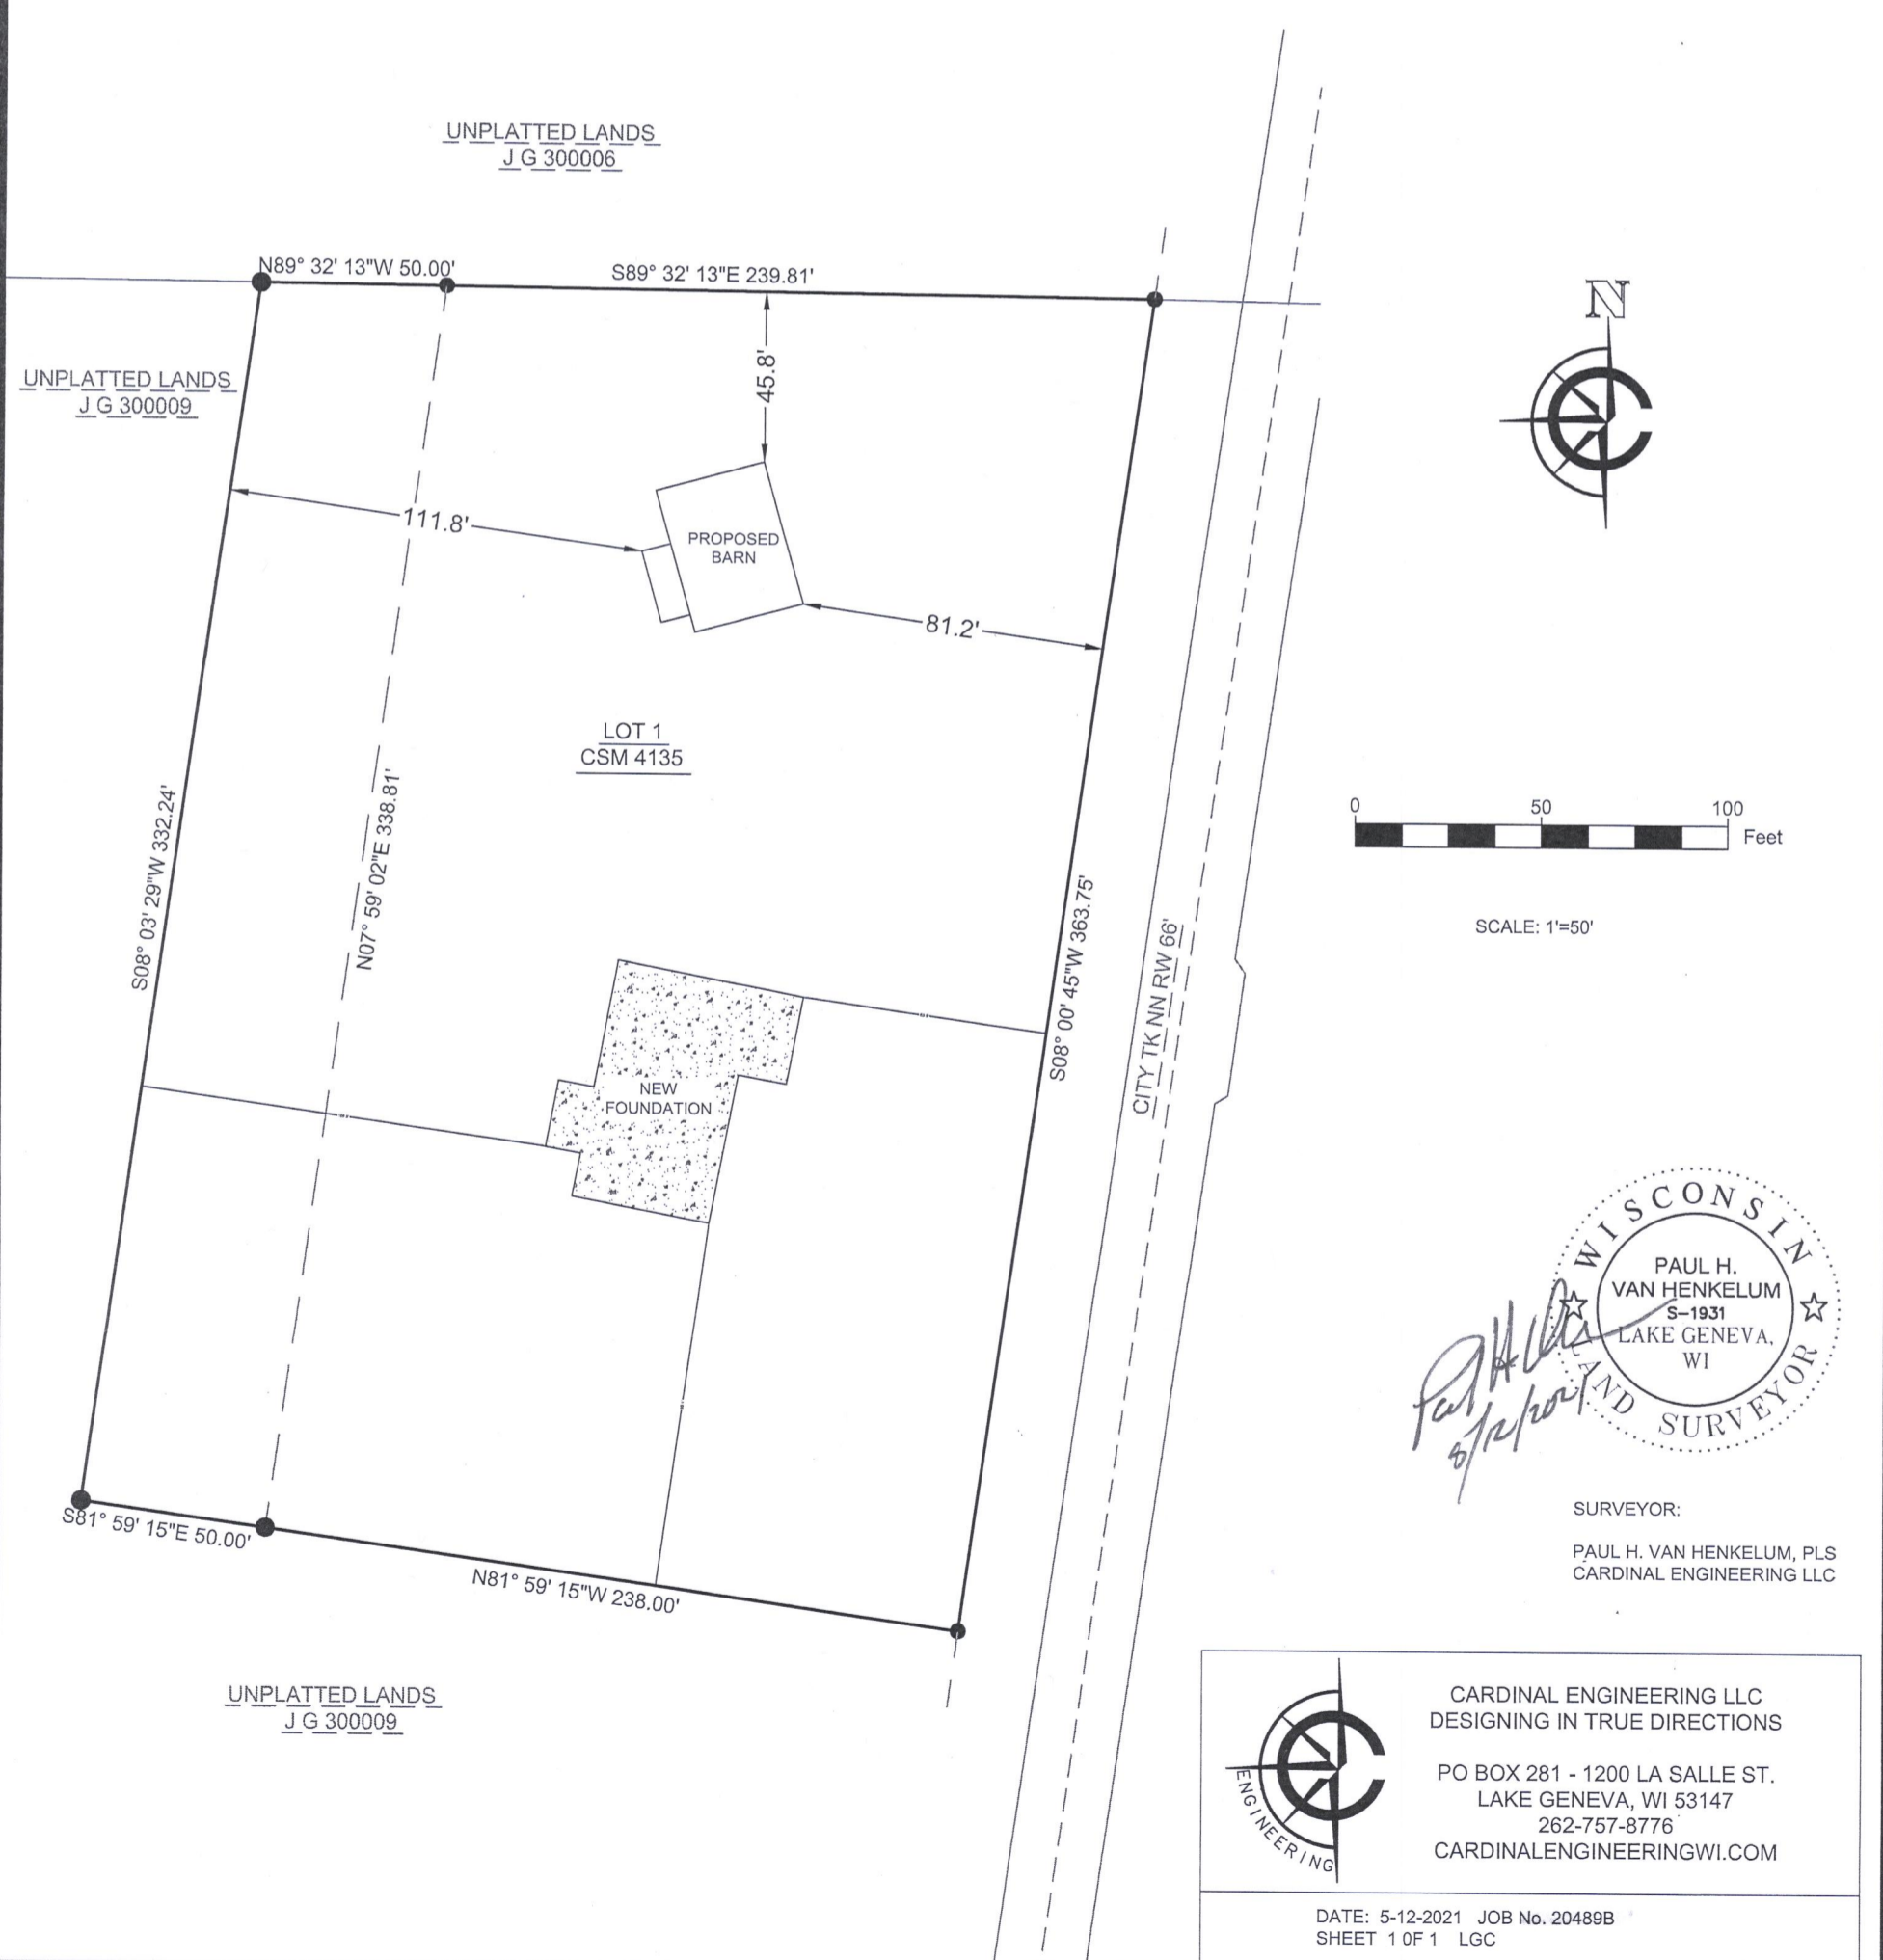

SURVEYOR:
PAUL H. VAN HENKELUM, PLS
CARDINAL ENGINEERING LLC

CARDINAL ENGINEERING LLC
DESIGNING IN TRUE DIRECTIONS

PO BOX 281 - 1200 LA SALLE ST.
LAKE GENEVA, WI 53147
262-757-8776
CARDINALENGINEERINGWI.COM

DATE: 5-12-2021 JOB No. 20489B
SHEET 1 OF 1 LGC

JA4135-1

217-4801